# 11716

### FORM C&GS-504

U.S. DEPARTMENT OF COMMERCE ENVIRONMENTAL SCIENCE SERVICES ADMINISTRATION COAST AND GEODETIC SURVEY

# DESCRIPTIVE REPORT

Type of Survey SHORELINE  Project From No. PH-6001 Office No. T-11716
LOCALITY
State MARYLAND
General locality KENT ISLAND
Locality SHIPPING CREEK
19 60-61
CHIEF OF PARTY George F. Wirth, Chief of Field Party W. E. Randall, Baltimore District Officer Alfred C. Holmes, Director, A. M. C.
LIBRARY & ARCHIVES
DATE

U.S. DEPARTMENT OF COMMERCE COAST AND GEODETIC SURVEY

### **DESCRIPTIVE REPORT - DATA RECORD**

	Т	- 11716			
PROJECT NO. (II):					<del> </del>
	Ph-6001				
FIELD OFFICE (II):			CHIEF OF PARTY	<u> </u>	
	Dhatammatria Dan	+ 723	LT (j.g.)	Coommo F.	Lii n+h
PHOTOGRAMMETRIC OFFICE (III):	Photogrammetric Par	رے ہے ل	OFFICER-IN-CHA		MTT. OII
PROTOGRAMMETATO OF FIGE A.M.					
···-	Baltimore, Maryland		William E.	Kandail	
INSTRUCTIONS DATED (II) (III):	January 28, 1960 February 4, 1960 February 22, 1960				
METHOD OF COMPILATION (III):	Kelsh Plotter				
MANUSCRIPT SCALE (III):		STEREOSCO	PIC PLOTTING INS	STRUMENT SCA	LE (III):
	1:10,000	1:5,00	00		
DATE RECEIVED IN WASHINGTON OF	FICE (IV):	DATE REPO	Pantograp)	·····	<u> </u>
DATE REGEIVED IN MAGNITOTER C.	FIGE (197)	DRIE NE. S	/R125 10 11/101.5.	TE CHART D.	NOTI NOT.
ABBLIED TO CHART NO		DATE:		DATE REGIS	TEREN INA
APPLIED TO CHART NO.		UA1E:		DATE REGIS	TERED (IV):
GEOGRAPHIC DATUM (III):			VERTICAL DATU	м (III): МН.	M
	N. A. 1927		HIXX XXXXXX Elevations shown Elevations shown i.e., mean low wat	as (25) refer to as (5) refer to s	mean high water sounding datum
REFERENCE STATION (III):	,				
	SHIP, 1933				
LAT.:	LONG.:		ADJUSTED		<del></del>
38° 531 27.530" (848.9m)	)   76° 20° 18.193"(4)	38.5 m)	XXXXXXXXXXXX	:	
PLANE COORDINATES (IV):			STATE		ZONE
	x =		Maryland		
ROMAN NUMERALS INDICATE WHETH	HER THE ITEM IS TO BE ENTER	RED BY (II) FI		PHOTOGRAMME	ETRIC OFFICE.
OR (IV) WASHINGTON OFFICE. WHEN ENTERING NAMES OF PERSON	INEL ON THIS DECORD GIVE TO	WE SHONAME	AND INITIALS NO	T INITIALS ONI	V

U.S. DEPARTMENT OF COMMERCE COAST AND GEODETIC SURVEY

	DESC	RIPTIVE REPORT - DATA RECORD	•
FIELD INSPECTION BY (II):	Robert S	E. Natto Tibbets Specht	DATE: February 22 - March 1, 1960
EAN HIGH WATER LOCATION	(III) (STATE DATE	E AND METHOD OF LOCATION):	
	J anuary	ll, 1960, Photogrammetric	
PROJECTION AND GRIDS RULE	R. A. C.	•	DATE 11/28/60
PROJECTION AND GRIDS CHEC			DATE
	J. D. C.		11/29/60
CONTROL PLOTTED BY (III):	D. M. Br	ant	12/7/60
ONTROL CHECKED BY (III):	J. D. Mo	Evoy	DATE 12/7/60
SOURCEREOSCOP		rension by (III):	DATE 3/29/60
TEREOSCOPIC INSTRUMENT C	OMPILATION (III)	: PLANIMETRY  J. D. McEvoy	12/21/60
		CONTOURS	DATE
MANUSCRIPT DELINEATED BY	(111);		DATE
	J. C. Cr	egan	9/11/61
CRIBING BY (III):			DATE
PHOTOGRAMMETRIC OFFICE R	EVIEW BY (III):	<del>_</del>	DATE
	E. L. Wi	lliams	6/7/61

U.S. DEPARTMENT OF COMMERCE COAST AND GEODETIC SURVEY

### DESCRIPTIVE REPORT - DATA RECORD

CAMERA (KIND OR SOURCE) (III):


C&GS camera type "S" focal length.

	P	HOTOGRAPHS (III)				
NUMBER	DATE	TIME	SCALE	S1	TAGE OF TH	DE
60 <b>-</b> S-9132 thru 9134 9148	11/1/60 "	1122 1145 1145	1:25,000	- 0.1 <sup>1</sup> - 0.1 <sup>1</sup> - 0.2 <sup>1</sup>	(Easte: (Chesa)	rn Bay) peake B
					of tide ed to MI	
		TIDE (III)	(from predicted	RATIO OF	MEAN	SPRING
				RANGES	RANGE	RANGE
EFERENCE STATION:	Baltimore				1.11	1.31
UBORDINATE STATION:	Thomas Point	Shoal Light			0.91	1.01
OBORDINATE STATION:	Kent Island Na	arrows			1.21	1.4
Atlantic Marine Center GERNAGINAMENTE REVIEW BY		H. Bishop		DATE:	04-05-72	2
PROOF EDIT BY (IV):				DATE:		
TUMBER OF TRIANGULATION STA	TIONS SEARCHED FO	OR (II): 13	RECOVERED:	IDENTIFIE	D: 14	
UMBER OF BM(S) SEARCHED FOR	R (II):	0	RECOVERED:	IDENTIFIE	0	
NUMBER OF RECOVERABLE PHOT	O STATIONS ESTABL	ISHED (III):	1			
SUMBER OF TEMPORARY PHOTO	HYDRO STATIONS ES	TABLISHED (III):				
REMARKS:						

T-11716

COMPILATION RECORD	COMPLETION DATE	REMARKS
Final Advance Manuscript	Nov. 1961	Supersedes all previous copies
Geographic name change	Nov. 1962	Supersedes all previous copies
Final Review	April 1972	

## PROJECT PH-6001 SHORELINE MAPPING 1:10,000 Scale KENT ISLAND Maryland

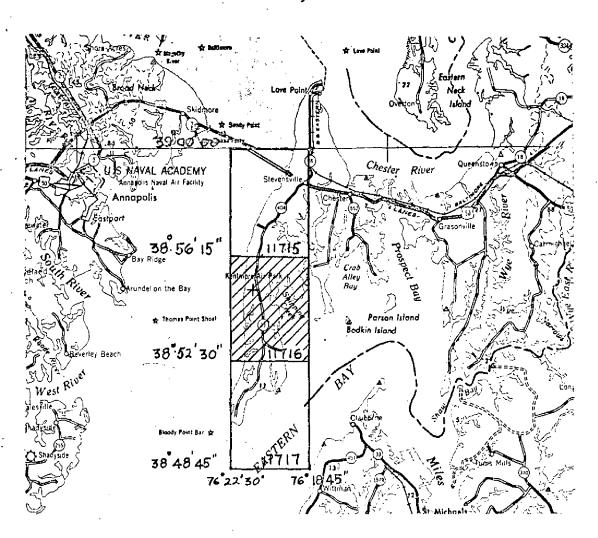

### Offical Mileage for Cost Accounts

Sheet Number	Area Sq. Mi.	Lin., Miles Shoreline
11715 11716 11717	6 7 3 Total 16	19.2 22.8 12.0 54.0

### SUMMARY

### DESCRIPTIVE REPORT T-11716

This 1:10,000 scale shoreline manuscript is the center one of three maps comprising Project PH-6001, Kent Island, Maryland, on the east side of Chesapeake Bay.

Field inspection was completed on March 4, 1960.

Initial compilation, based on a stereoplanigraph bridge which was not entirely satisfactory, was done graphically during March 1960. Single-lens photography, flown at 1:25,000 scale and ratioed to 1:10,000 scale, was used. A new position for Station "Price's House, South Chimney" was established and identified and a new bridge, which was very satisfactory, was run, using the same photographs. The map was re-compiled in December 1960 by Kelsh Plotter, using control points established by the stereoplanigraph bridge.

Limited field edit was accomplished in July 1961 by a party from the Baltimore Office. No Field Edit Report is available other than "Notes to the Reviewer". See page 19 of this Descriptive Report.

Final review was done at the Atlantic Marine Center in April 1972.

The compilation manuscript was a vinylite sheet 3 minutes 45 seconds in latitude by 3 minutes 45 seconds in longitude.

A cronaflex copy of the final reviewed manuscript and a negative have been forwarded for record and registry.

### FIELD INSPECTION REPORT

### PROJECT PH-6001

### MARYLAND

### 2. AREAL FIELD INSPECTION

This report is submitted for the entire project, covering three sheets along the west side of Kent Island, all of which falls in Queen Annes County, Maryland.

The work was accomplished during the period 8 Feb. 1960 to 4 March 1960.

The area is sparsely settled. The major occupations in the area are farming and fishing. The summer vacation population appears to be growing since several of the farms along the waterfront have been subdivided into building lots.

The field inspection was carried out on 1960 ratio prints, 1:10,000. The photographs were of excelent quality and little or no difficulty was encountered identifying objects.

### 3. HORIZONTAL CONTROL

All horizontal control stations, as indicated on the project diagram, were recovered with the following exceptions.

Sheet 11716:

The center mark at station JACK 1933 has been destroyed by erosion of the bank. RM No 1 1933-1954 was identified in its stead, by sun azimuth.

The C.B.A. EXPERIMENTAL TOWER 4 broke off appoximately 20 feet above the ground in 1958. The point occupied by the instrument during identification of the station was the intersection of the diagonals. There is also a C&GS Bench Mark set in the NW corner of the base of this tower, and the description is not clear as to whether the center of the tower or the bench mark is the Triangulation station.

Sheet 11717:

Approx. 8 inches has been broken off the top of the center mark of Station BELL. The base of the center mark was occupied during identification. Its position was checked by setting the theodolite over the base and observing the angle between BLOODY PT BAR LIGHTHOUSE and RM No 1, and checking the published distance. RM No 1 was recovered by this method.

Triangulation Stations Sunny, 1960 and KENTMORR, 1960 were established by a three point fix.

Kent Island Speed Trial North and South frount and rear ranges and David Taylor Model Basin South Base were located by traverse from stations SUNNY and KENTMORR.

### 4. Vertical Control

Vertical control was limited by Project instructions to the recovery of existing tidal bench marks. The only tidal bench mark in the project, BM Y 75 was identified using the photo point method.

### 5. Contours and Drainage

Contours not applicable.

There are a number of small perennial and intermittent streams and ditches in the area, all of which have been indicated on the field photographs.

### 6. Woodland Cover

Woodland cover was classified in accordance with Topographic Manuel Part 2 (Ref. 5433). Swamp limits were outlined throughout the project.

### 7. Shoreline and Alongshore Features

The eastern shore of Kent Island is bounded by low, hard marsh in many places, the hard ground usually starts at the tree line. The marsh areas have been deliniated on the photographs.

The western shore of Kent Island is frequently a 6-15 foot bluff, subject to severe erosion. The MHW is usually at the base of the bluff.

### 8. Offshore Features

Mooring stakes in Warehouse and Cox creeks could not be seen on the photographs, but in most cases are not a hazard to navigation.

Fish trap stakes off the west side of Kent Island are shifted from year to year. One trap is just south of Kentmorr Marina, another north of Kent Point. The owner of the Kentmorr Marina states that they are not dangerous, a fishing boat could run over the stakes with no harm.

### 9. Landmarks and Other Aids

Three landmarks were deleated, and three new landmarks were established. All were reported on Form 567.

### 10. Boundries, Monuments, and Lines

No boundaries were deliniated, in accordance with the project instructions.

### 11. Other Control

Prominent natural objects were pricked to meet minimum spacing requirements, and provide photo-hydro stations.

### West side

11715 11716

Chimney 1960 Pier 1960

NW corner 1960 Chimney 1960

NE chimney 1960 NW corner old barge 1960

Chimney 1960 North chimney 1960

North end wood Blkd 1960 Chimney 1960 Chimney 1960

Chimney 1960 11717 Chimney 1960

South end wood Blkd 1960 Chimney 1960 Chimney 1960 West gable 1960

NW corner ferry dock 1960 Flag pole 1960 West gable 1960

East side

West gable 1960

11717 1.1716

South gable 1960 South chimney 1960
Brick chimney 1960
Chimney 1960

Cupola 1960

### 12. Other Interior Features

Roads, buildings, and other features were classified according to the project instructions. There is one sod landing field in Map 11716, next to Kentmorr Marina. The limits have been deliniated on the photo. Gasoline is available, and the strip has a windsock on the south side.

### Geographic Names

A report will be sent under separate cover,

### 14. Special reports and Supplimental data

A Coast Pilot report will be sent under separate cover.

Additional recovered triangulation and new triangulation data will be sent at a later date.

List of triangulation lost, not recovered, or missing will be sent at a later date.

Respectfully submitted,

Robert S. Tibbetts

### PHOTOGRAMMETRIC PLOT REPORT PH-6001 Kent Island, Maryland 29 March 1960

### 21. Area Covered

This project covers sheets T-11715, T-11716 and T-11717.

### 22. Method

A single strip (photos 60-S-9143 thru 9151) was bridged on the stereoplanigraph to provide pass points for graphic compilation. This strip was adjusted on the IBM 650. All points were then plotted on the manuscripts by means of a coordinatograph.

### 23. Adequacy of Control

Horizontal control provided complied with the project instructions. Some difficulty was encountered with station "PRICE'S HOUSE SOUTH CHIMNEY 1932". It was determined by further field work that the house had been moved. A new position was established near the station which held adequately in the bridge. Positions for the final compilation should be plotted from this final adjustment.

### 24. Supplemental Data

None


### 25. Photography

The photography was adequate as to coverage, overlap and definition, with the quality of the diapositives being excellent.

SUBMITTED BY:

APPROVED BY:

E. H. Ramey

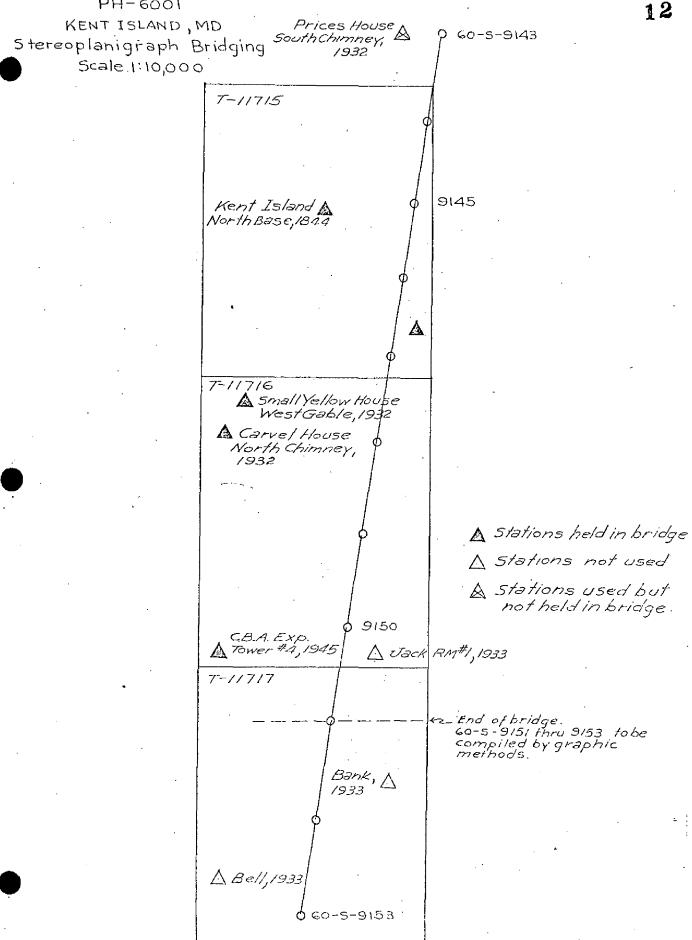

FORM **164** (4-23-54)

DESCRIPTIVE REPORT U.S. DEPARTMENT OF COMMERCE

COAST AND GEODETIC SURVEY CONTROL RECORD SCALE OF MAP 1:10,000

PROJECT NO. Ph-6001

MAP T-..11,716.

SCALE FACTOR 1.000

FACTOR DISTANCE FROM GRID OR PROJECTION LINE IN METERS (BACK) FORWARD DISTANCE FROM GRID OR PROJECTION LINE IN METERS (BACK) N.A. 1927-DATUM FORWARD DATUM OR PROJECTION LINE IN METERS DISTANCE FROM GRID IN FEET, 1324.0 (BACK) 153.4 5966 897<sup>4</sup> 5892 8983 FORWARD 1370.6 200.0 29 Ħ 29 1 LONGITUDE OR x COORDINATE LATITUDE OR y - COORDINATE 988,752.14 981,289,28 387,305,78 980,921,74 980,882,28 980,913,59 396,330,94 981,118,52 385,853,50 380,327,64 380,466,44 380,221.85 394,496,61 980,656,15 982,836,95 394,829,36 392,312,91 988,316.87 399,261,07 980,394,67 DATUM N.A. 1927 1927 N.A. = = = = = **=** = SOURCE OF Vol.II B. 386 PC-188 PC-236 PC-106 PC-133 PC-50 (INDEX) PC-51 PC-50 Comp. Äď = Carvel House, North SS B David Taylor Model Small Yellow House Tower No. 4, 1945 Then, (MSFC) 1909 CBA Experimental Tower No. 4, 1945 Tower No. 4, 1945 Basin South Base, Large White House CBA Experimental CBA Experimental West Gable 1932 STATION Chimney, 1932 Chimney 1932 Matta, 1932 Ship, 1933

CHECKED BY. E. L. Williams 12/5/60 DATE. 1 FT. = 3048006 METER Henry P. Eichert

1132.3

391.7

961,4

1304.5 1259.0

219.5

2650 562,6

980,869,35 401,845,70 981,285,09

=

384

Kentmorr, 1960

Sunny, 1960

=

382

395,720,24

DATE.

12/5/60

COMM- DC- 57843

3 1

FORM **164** (4-23-54)

· U.S. DEPARTMENT OF COMMERCE DESCRIPTIVE REPORT

COAST AND GEODETIC SURVEY CONTROL RECORD

FACTOR DISTANCE FROM GRID OR PROJECTION LINE IN METERS COMM. DC-57843 SCALE FACTOR 1,000 14 (BACK) FORWARD DISTANCE FROM GRID OR PROJECTION LINE IN METERS (BACK) N.A. 1927-DATUM FORWARD SCALE OF MAP 1:10,000 DATUM OR PROJECTION LINE IN METERS DISTÂNCE FROM GRID IN FEET, 972.1 961.0 1289.4 1300.6 1153.6 676.6 728.2 (BACK) 1204.7 FORWARD 551.9 847.4 563.0 370.4 234.6 319,3 223,4 795.8 PROJECT NO. Ph-6001 LONGITUDE OR x-COORDINATE LATITUDE OR y . COORDINATE 401,810.79 982,780,10 981,047,66 401,847.27 981,215.21 395,769,57 395,732,94 982,610,84 DATUM NA 1927 Ξ = SOURCE OF 385 Vol II p. 383 (INDEX) Md. = = Kent Island Speed Trial, North Front MAP T-..11716. Trial, North Rear Kent Island Speed Kent Island Speed Kent Island Speed Trial South Front Range, 1960 Trial South Rear STATION Range, 1960 1960 Range, 1950 Range Range

12/5/60

DATE..

E. L. Williams

CHECKED BY ...

12/5/60

DATE.

| FT.=.3048006 METER Henry P. Eichert

COMPUTED BY:..

### COMPILATION REPORT Project Ph-6001 T-11716

### 31. DELINEATION

New projections were used for compilation by Kelsh Plotter on which were plotted control and pass points from the re-adjusted steroplanigraph bridge. Previously compiled shoreline was transferred holding to common shoreline points. Minor changes were made during compilation.

### 32. CONTROL

Horizontal control was adequate.

### 33. SUPPLEMENTAL DATA

Final Name Standard, dated November 30, 1960.

### 34. CONTOURS AND DRAINAGE

Drainage was taken from field inspection. In a few places prominent ditches were added.

Contours are inapplicable.

### 35. SHORELINE AND ALONGSHORE DETAILS

Shoreline inspection was adequate. In a few places where marsh areas were narrow and minute they were omitted. No low water or shoal lines shown on the manuscript.

Landmark bluffs were delineated in areas where field inspection indicated bluffs six or more feet high. The limits of the landmark bluffs were determined during a field trip made in July 1961; the criterion being that the bluffs be free of vegetation as well as precipitous.

One newly dredged inlet with a seven foot depth and an eighty foot channel (information obtained from the dredge operator) has been shown. Locations of this inlet and of a road leading to it were obtained in July 1961 by planetable methods on photograph 60-S-9149.

### 36. OFFSHORE DETAILS

No comment.

### 37. LANDMARKS AND AIDS

Form 567 was submitted January 18, 1961, for three landmarks which were located during compilation, and for four landmarks located by traverse.

### 38. CONTROL FOR FUTURE SURVEYS

Of the nine (9) prominent natural objects listed in paragraph 11 of the Field Report; one, CHIMNEY 1960, was selected as a topographic station to meet minimum spacing requirements. The other eight (8) were located as photo-hydro stations and will not be carried forward.

### 39. JUNCTIONS

To the north with T-11715.

To the south with T-11717.

There are no contemporary surveys to the east and west.

### 40. HORIZONTAL AND VERTICAL ACCURACY

No comment.

41. - 45 Innaplicable.

### 46. COMPARISON WITH EXISTING MAPS

AMS Sheet 5761 IV NE Kent Island, Maryland, scale 1:25,000 revised 1946, 3rd edition dated 1950. This map is based on Bureau Surveys T-5323 (1942) and T-5423 (1942).

### 47. COMPARISON WITH NAUTICAL CHARTS

Chart No. 550, scale 1:40,000 3rd edition, 1 - 16 - 61.

Items to be applied to nautical charts immediately: None.

Items to be carried forward: None.

Respectfully submitted

Joseph D. McEvoy Carto. (Photo.)

Approved and Forwarded

Joseph Steinberg

Acting Baltimore District Officer

### April 14,1972

GEOGRAPHIC NAMES

FINAL NAME SHEET

PH-6001 (Maryland)

T-11716

Batts Neck

Chesapeake Bay

Carter Creek Carville Pond Cox Creek

Craney Creek

Eastern Bay

Kent Island

Kent Island Estates

Kentmarr Marina

Mattapex

Philpots Islands

Romancoke

Shipping Creek

South Prong

South Prong Shipping Creek

Tolson Creek

Warehouse Creek

Approved:

Chief Geographer

Prepared by

Cartographic Technician

### PHOTOGRAMMETRIC OFFICE REVIEW

T. 11716

1. Projection and grids2. Title3.	Manuscript numbers 54. Manuscript size
	1 1 1 1 1 1 1 1 1 1 1 1 1 1 1 1 1 1 1
CONT	ROL STATIONS
5 Horizontal control stations of third-order or higher a	accuracy6. Recoverable horizontal stations of less
	7. Photo hydro stations She 8. Bench marks
9. Plotting of sextant fixes 10. Photogramme	stric plot report 11. Detail points
ALONG	SHORE AREAS
( Nautio	cal Chart Data)
<i>a</i> .	4. Rocks, shoels, etc. 15. Bridges 16. Aids
to navigation17. Landmarks18. C	other alongshore physical features19. Other along-
shore cultural features	
•	,
	CAL FEATURES
20. Water features 21. Natural ground cover	r22. Planetable contours23. Stereoscopic
instrument contours 24. Contours in general	ral 25. Spot elevations 26. Other physical
features Slux	
CHITHE	RAL FEATURES
27. Roads La 28. Buildings Sla 29. Reile	roads 30. Other cultural features Sa
ВО	UNDARIES
31. Boundary lines 32. Public land lines	
· ·	
	ELLANEOUS
33. Geographic names 34. Junctions	35. Legibility of the manuscript 36. Discrepancy
overlay Hu 37. Descriptive Report Llu 38.	Field inspection photographs <u>Sh</u> 39. Forms <u>th</u>
40. <u>5 L. William</u> Reviewer	Supervisor, Review Section or Unit
41. Remarks (see attached sheet)	
FIELD COMPLETION ADDITIONS A	ND CORRECTIONS TO THE MANUSCRIPT
42. Additions and corrections furnished by the field co	empletion survey have been applied to the manuscript. The
manuscript is now complete except as noted under ite	m 43.
Compiler	Supervisor
- arriprial	and the state of t

43. Remarks:

# NOTES TO THE REVIEWER Ph-6001 T-11715 & T-11716

Station LOG CABIN CLUB WEST GABLE, 1932 - was not plotted on manuscript T-11715. No recovery note was submitted nor is a building visible on any photograph.

Stations which plotted on/or behind the MHWL as compiled were not removed from the manuscript if the field party reported them as lost or "unable to find."

While on a field trip during July of 1961, the reviewer had an opportunity to do a limited field edit of this project.

Changes found are shown on the original field inspection photographs in purple ink.

Major changes are discussed in detail in the descriptive reports of the appropriate manuscripts under the pertinent side headings.

A questionable geographic name encountered during this field trip is discussed in these notes because the geographic name report is not available in this office.

The geographic name "Carville Pond" on Survey T-11716 was questioned by Mr. R. L. Willis whose address is 6200 Fointdexter Road, Rockville, Maryland. Mr. Willis, who owns and is developing the property adjoining Carville Pond, states the pond is known as "Prices Creek" locally. In addition he said, "Prices Creek" appears on the old and new property deeds as well as in the records of the Corps of Engineers who gave him a permit for dredging an inlet into the pond. On the sketch accompanying this permit the pond is referred to as "Queen Anne Sound".

Several of the duck blinds which are delineated from the 1960 photography were not visible from the shore in 1961. No attempt was made to visit the location by boat.

Duck blinds in the waters south of Kent Point were seen, but apparently are in a poor state of repair.

FINAL REVIEW NOTE: This page, which accompanied the Compilation Report written in August, 1961, is included in the Descriptive Report because it is the only report available for Field Edit of Project PH-6001.

Charles H. Bishop

04-03-72

U.S. DEPARTMENT OF COMMERCE NETIC SURVEY COAST AND G

Form 567

# MUNICIPALITATION PATA PARTE LANDINARKS FOR CHARTS

STRIKE OUT TWO TO BE CHARTED YOU'S SELLY YOU'S SELLY YOU'S SELLY TO SELLY TEN

Baltimore, Maryland

1961

18 January

I recommend that the following objects which have (1/4/1/4/4) been inspected from seaward to determine their value as landmarks be Henry P. Eichert charted on (fylited/from)/the charts indicated.
The positions given have been checked after listing by

		٠ _		1	,	, \	, \	, \	ı	1	t	į .		ľ	1	į	l	ł	
Chief of Party.		CHARTS		550	=   	: :	ر 3	=			,	-							
hlef	TPAHO				<del> </del>						 *	<del> </del>	<del> </del>		-		·	-	
0	ļ		HYYS	-11	Ж	<u></u> N_	<u>}</u> ;	M.		-	 				-			F	
			-	0						┨	 				<del>                                     </del>			╁	_
Randall	÷	DATE	LOCATION	2/24/60	   =	11	4	r									i `		
Milliam B. R	METHOD	LOCATION NOTION	SURVEY No.	rhoto 11715	31716	<b>5</b>	£	11717			•								
14111			DATUM	1927 1927	=	. #	E.												
		rube*	" D.P. METERS	03.41. 82	17.23	15.91	115,28	10.3 218											
	POSITION	+ ביאפענתם	~	13	20	1.9	61	8	,		 <b>-</b>		-	<b>-</b>	<del>                                      </del>		<b></b>		1
	Š		7.	126	26	94	92	176				 	<del></del>		1	4		<u> </u> -	
		LATITUDE.*	" D.M. METERS	1557	31.75		11.16	37.3											
		ואלו		38 57	33 54	38 55	38 55	38 51											
		<u> </u>	<u> </u>							-	 <del></del>				-			<del> </del>	
			BIGNAL				•		•					-		}			
	THEY LACE YES	7.24 LANG MAN 19.1.7	DESCRIPTION	Unite concrete gilo with tin roof. ht=16 (55) ft.	Unite concrete silo vith red roof. Nt=39 (51)	esserly, white, with gray roof ht=55 (87)	Easterly, unito with gray roof bt- (67),	Brick ht=31(35)		`									
	5.rait		CHANTING	SIIO	SILO	ሚኬፈ። ይፗኒው	ETTS CITS	XEIDITIO.											

gation, if rederenmined, shall be reported on this form. Revisions shall show both the old and new positions. The data should be considered for the charts of the area and not by individual field survey sheets. Information under each column heading should be given. USCOMM-DC 27128 This form shall be prepared in accordance with Hydrographic Manual, pages 800 to 804. Positions of charted landmarks and nonfloating aids to navi-

\* TABULATE SECONDS AND METERS -

2

Form 567 (10-15-58)

U.S. DEPARTMENT OF COMMERCE PETIC SURVEY COAST AND G

MONTH CONTINUE, AUTS/POR LANDMARKS FOR CHARTS

STRIKE OUT TWO.

Baltimore, Maryland

19\_61 18 January

I recommend that the following objects which have (ROBERTA) been inspected from seaward to determine their value as landmarks be charted on (deligationary) the charts indicated. ijský zakárés/ to be revised tský přízetas/

Henry P. Eichert The positions given have been checked after listing by

-	•			e ao dispar			errae -	alliam B	E. Händell	Chie	Chief of Party	<u> </u>
STATE	Barylan!-			al a section	POSITION	>		METHOD		161		
			5	CATITUDE *	TON	LONGITUDE		LOCATION	DATE	HD 21	CHARTS	ξ.
CHARTING	DESCRIPTION	SIGNAL	0	D.M. METERS	0	D. P. MEYERS	DATOM	GURVEY No.	LOCATION	DERAH ICHZWI M27YD	AFFECTED	0 0
OUE;	ا بنزار ا		38 58	1,501,	61 92	18.19	1.927	Photo 11715	3/12/60	14	37.	3/124
M. RAICE	Front target on treet, pare		38 35	366.122	76	1722.3	=	11716		×	=	
•	(NO.STAL TAND LYLED (RELAID)	-										
H. RANCS			88 88	374.3	76 21	26.793	F	r	a	H	=	]
•	TVIUM (COST MOMON HOSE HERON)	,										1
S. RANGE	Aront terget on steel polo htm32 (42)		38 55	06.053 136.8	76 23	1186.6	E	ន	=	N	ŗ	
•	TOTAL TRIVIAL TROUBLESON (COATS)											!
S. RANGE	Near tarjet on steel pole htw38 (54)		88 13	05.586 172.3	76 21	710.2	£	2	£	M	12	7
	(court rear reage 1960)								ne .			,
IIII CHILLESK	Formerly diarted as Carllat CHI ht=32 (41)		ਸ਼ ਜ	28.3	76 22	18.1	Þ	Photo. T-11717	6	Н	t	437
	-						. ,				_	ľ
							,2					•

This form shall be prepared in accordance with Hydrographic Manual, pages 800 to 804. Positions of charted landmarks and nonfloating aids to naviof the area and not by individual field survey sheets. Information under each column heading should be given.

\* TABULATE SECONDS AND INSTERS

2

USCOMM-DC 27128

### REVIEW REPORT T-11716

### SHORELINE

April 5, 1972

### 61. GENERAL STATEMENT:

See Summary on page 6 of this Descriptive Report.

An ozalid comparison print, pages 29 through 30, showing differences noted in Items 62, 63, and 65, is bound with the original of this report.

### 62. COMPARISON WITH REGISTERED TOPOGRAPHIC SURVEYS:

A comparison was made with Survey No. T-8266, scale 1:20,000, dated 1943. Differences between this survey and T-11716 are shown with blue on the comparison print. Interior features were not compared.

Also, a comparison was made with Surveys RS-729 and RS-730, scale 1:20,000, dated 1961. These maps were prepared by the Coast and Geodetic Survey for the State of Maryland, Department of Tidewater Fisheries, and show fishing area boundaries, which were not mapped on T-11716. The areas compared have no significant differences in shoreline or interior details.

T-11716 supersedes previous topographic surveys of the area for nautical chart construction purposes.

### 63. COMPARISON WITH MAPS OF OTHER AGENCIES:

A comparison was made with AMS SHEET 5761 IV NE, KENT ISLAND, MARYLAND, scale 1:25,000, revised 1946, 3rd edition dated 1950.

Since T-8266 was the base map for this AMS sheet, the shoreline and other details are the same on both maps. Therefore, the differences between the AMS map and T-11716 are the same as the differences between T-8266 and T-11716, and are shown with the same blue line on the comparison print.

### 64. COMPARISON WITH CONTEMPORARY HYDROGRAPHIC SURVEYS:

No contemporary hydrographic surveys were available for comparison.

### 65. COMPARISON WITH NAUTICAL CHARTS:

A visual comparison was made with Chart 550, scale 1:40,000, 11th edition, dated Dec. 25, 1971. Significant differences between this chart and T-11716 are shown with red on the comparison print.

Range lights at Kentmore Marina, Cox Creek Daybeacon 1 and Cox Creek Light 2 were installed after the date of this map and, therefore, are not mapped on T-11716.

The breakwaters and dolphins at Kentmore Marina, dolphins at the old ferry pier at Romancoke and a pier about 300 meters north of the old ferry pier, and a small basin along the south shore of Shipping Creek north of Mattapex are not visible on the photographs and are not mapped.

### 66. ADEQUACY OF RESULTS AND FUTURE SURVEYS:

This map was compiled in compliance with Project Instructions and Bureau requirements. The Photogrammetric Plot Report states that the bridge was satisfactory after the identification.problem at Station "Price's House, South Chimney 1932" was resolved and the bridge was re-adjusted. Therefore, it is assumed that the accuracy of this map meets the National Standards for Map Accuracy. No accuracy tests were run in the field.

Reviewed by:

Charles H. Bishop Cartographer

Charles H. Bishop

April 5, 1972

Approved for forwarding:

Melvin J. Mmbach, CDR, NOAA


Chief, Photogrammetry Division, AMC


Approved:


Alfred C. Holmes RADM, NOAA Director, Atlantic Marine Center


Approved:


Chief, Photogrammetric Branch pot Chief, Coastal Mapping Division

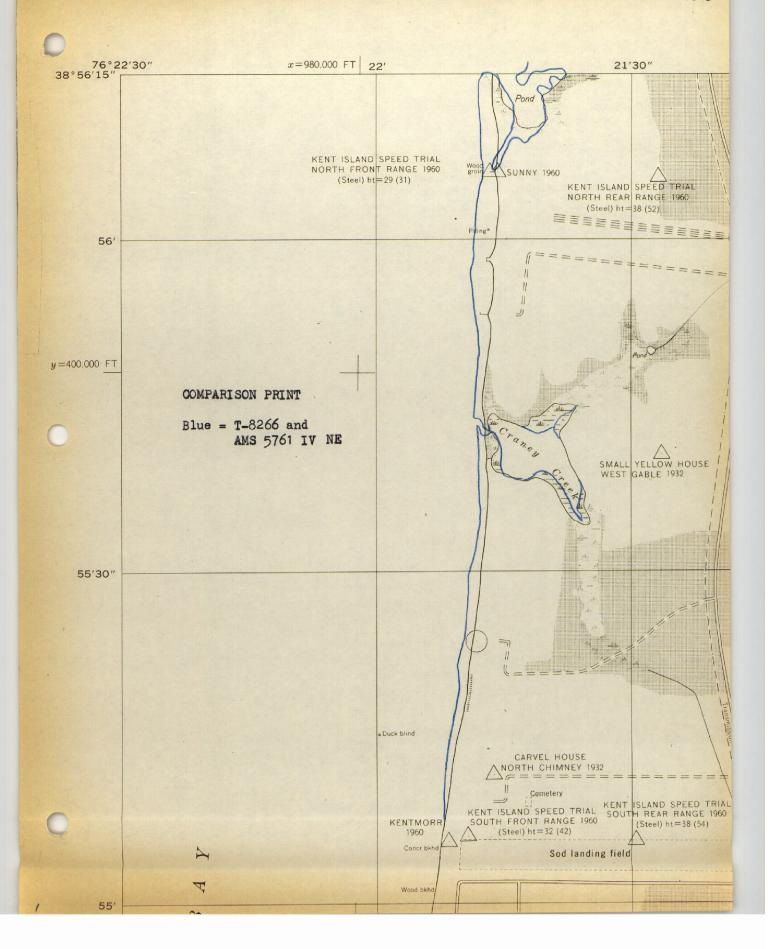


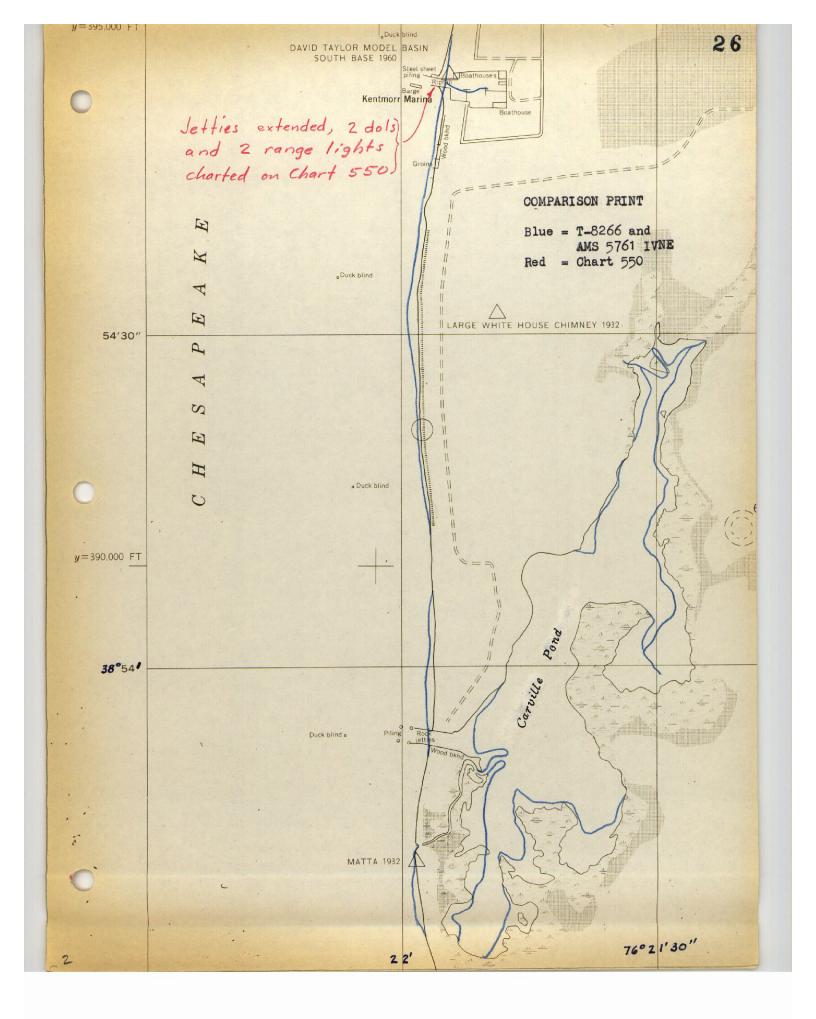

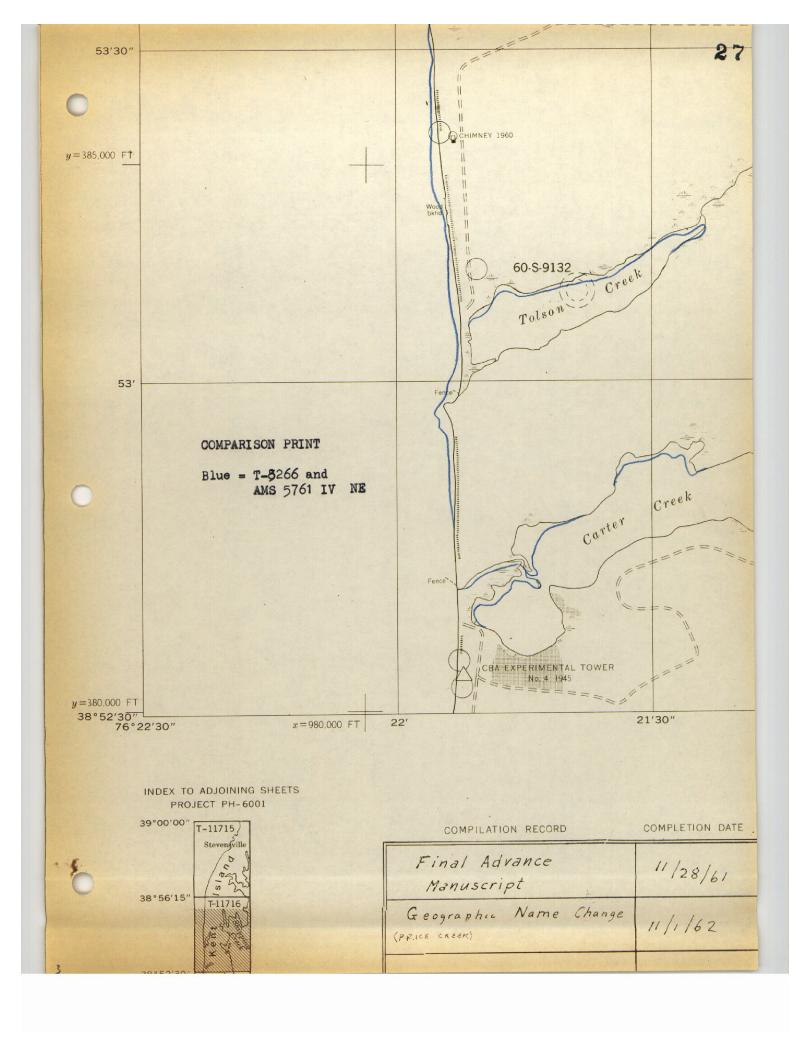

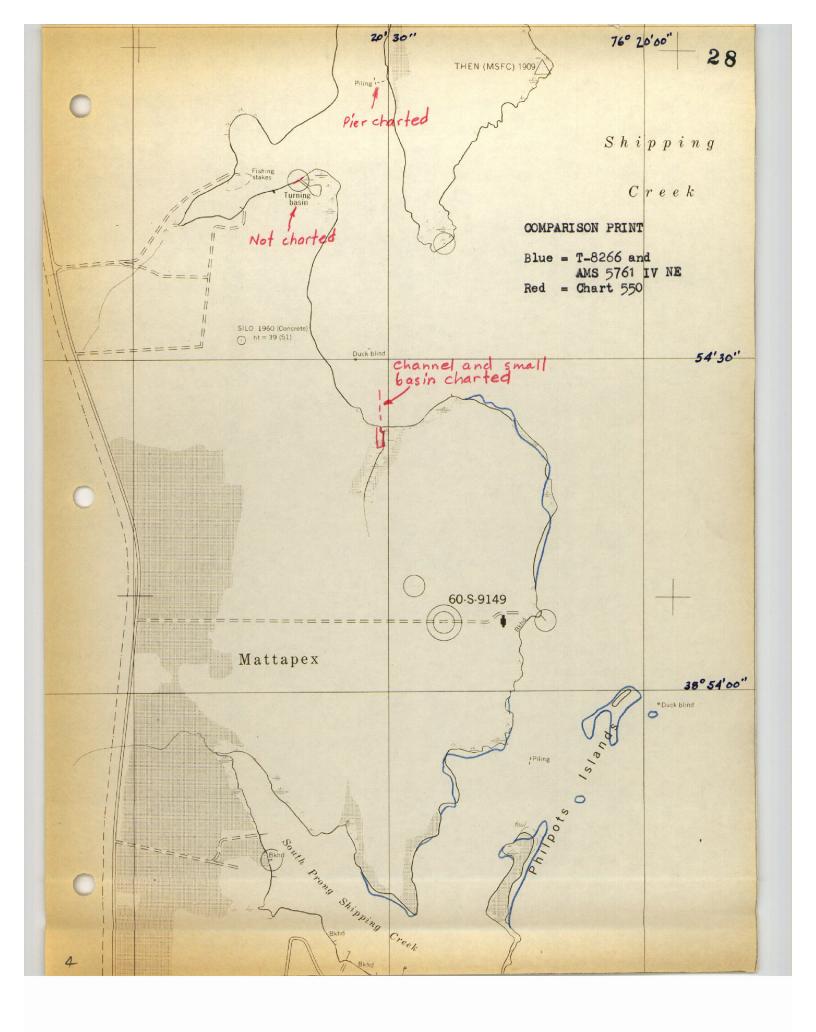

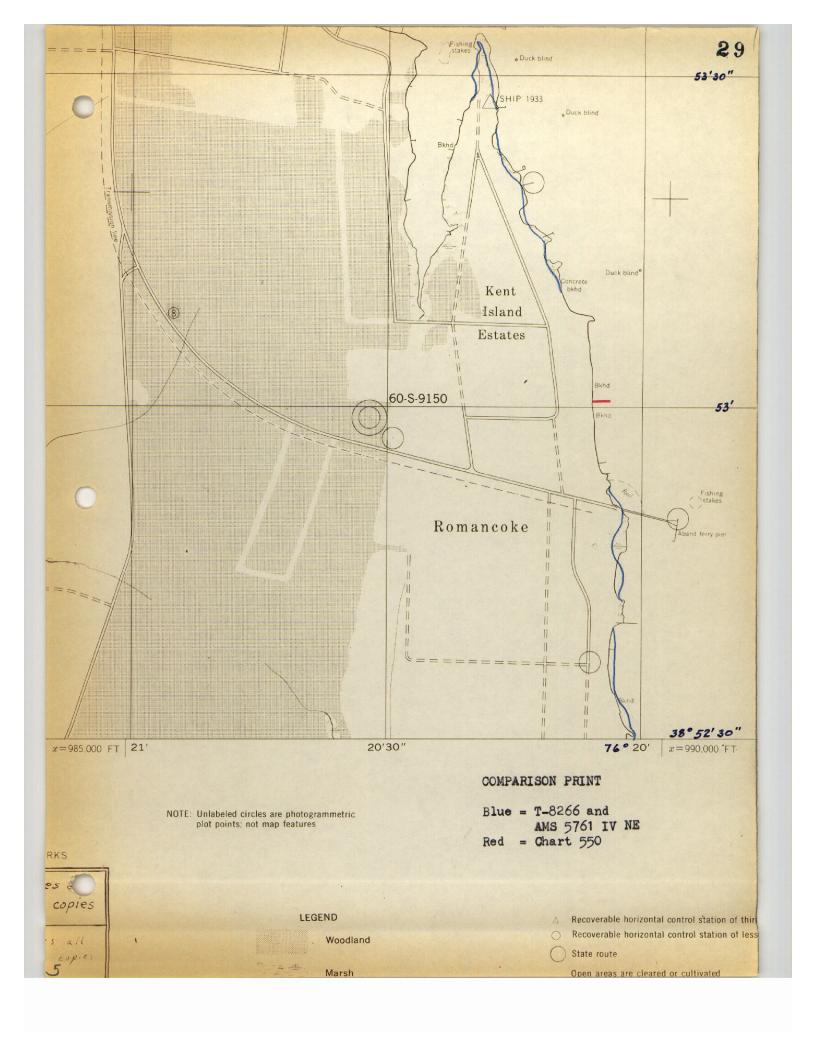

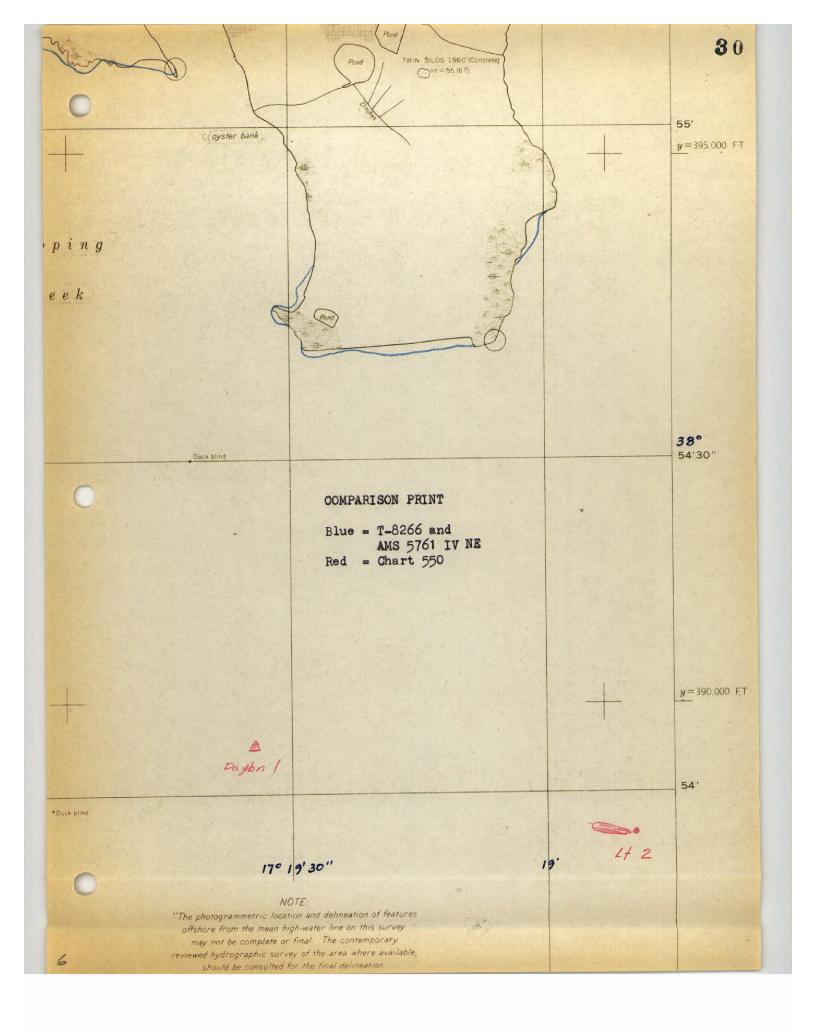

### NAUTICAL CHART DIVISION

### **RECORD OF APPLICATION TO CHARTS**

FILE WITH DESCRIPTIVE REPORT OF SURVEY NO.

### INSTRUCTIONS

A basic hydrographic or topographic survey supersedes all information of like nature on the uncorrected chart.

Letter all information.
 In "Remarks" column cross out words that do not apply.
 Give reasons for deviations, if any, from recommendations made under "Comparison with Charts" in the Review.

CHART	DATE	CARTOGRAPHER	REMARKS
550	7/17/72	BiFernandury	Full Perc Bales: After Verification Review Inspection Signed Via
			Drawing No.
			Full Part Before After Verification Réview Inspection Signed Via
			Drawing No.
			Full Part Before After Verification Review Inspection Signed Via
			Drawing No.
			Full Part Before After Verification Review Inspection Signed Via
			Drawing No.
			Full Part Before After Verification Review Inspection Signed Via
			Drawing No.
		: 	Full Part Before After Verification Review Inspection Signed Via
			Drawing No.
			Full Part Before After Verification Review Inspection Signed Via
			Drawing No.
			E-II Dan Data Atan Waitingin Bullanta India Cinal Via
			Full Part Before After Verification Review Inspection Signed Via  Drawing No.
			Pull Due Defende Africa De la Company de la
			Full Part Before After Verification Review Inspection Signed Via Drawing No.
<u>,</u>			Full Part Before After Verification Review Inspection Signed Via Drawing No.
		, , , , , , , , , , , , , , , , , , ,	