# 12619

#### Form 504

U. S. DEPARTMENT OF COMMERCE
COAST AND GEODETIC SURVEY

# DESCRIPTIVE REPORT

Type of Survey SHORELINE (Photogrammetr	ic)
Field No. Office No. T-12619	
LOCALITY	
State SOUTH CAROLINA	
General locality LESTON, S. C. TO SAVANNAH	, GA.
Locality PORT ROYAL SOUND	
-	
19 64-65	
CHIEF OF PARTY Joseph K. Wilson, Chief, Photo Party Allen L. Powell, Director, A.M.C	
LIBRARY & ARCHIVES	<u></u>
	,;
DATE	

USCOMM-DC 5087

FORM C&GS-181a

U.S. DEPARTMENT OF COMMERCE ENVIRONMENTAL SCIENCE SERVICES ADMINISTRATION COAST AND GEODETIC SURVEY

	DESCRIPTIVE REPO	DRT - DATA	A RECORD		
	Т	-12619		_	
PROJECT NO. (II):					
Job PH-6407					
FIELD OFFICE (II):			CHIEF OF PARTY		
Beaufort, South	Carolina		Joseph K. Y	filson	•
PHOTOGRAMMETRIC OFFICE (III):			OFFICER-IN-CHAR	den L. Po	owell
Atlantic Marine	Center		. Di	irector	
INSTRUCTIONS DATED (II) (III):		· · · · · · · · · · · · · · · · · · ·			· · · · · · · · · · · · · · · · · · ·
	April 23, 1964 September 28, 1964 December 22, 1964		Amendment #1		
METHOD OF COMPILATION (III):					,
Kelsh					
		·			. –
MANUSCRIPT SCALE (III):			PIC PLOTTING INST		
1:20,000			) pantographed	1 to 1:20	,000
DATE RECEIVED IN WASHINGTON OF	FICE (IV):	DATE REPO	RTED TO NAUTICAL	L CHART BRA	NCH (IV):
1					
APPLIED TO CHART NO.		DATE:		DATE REGIS	TERED (IV):
GEOGRAPHIC DATUM (III):		<u> </u>	VERTICAL DATUM	(III): MHW	
•			MEANTSEATEVEL	EXCEPT AS	FOLLOWS:
Y 4 7000			Elevations shown as Elevations shown as		_
N.A. 1927			i.e., mean low water	_	
			•		
	<u> </u>			7-11	
REFERENCE STATION (III):	,				
GRAVE, 1931 🗸	<u> </u>				
LAT.:	LONG.:	,	ADJUSTED		
320 14: 48".462 (1492.7	1) 80 44 46.7181	(1208.9m)	UNADJUSTED		i
LANE COORDINATES (IV):			STATE		ZONE
=150,519.74 ft.	×= 2,078,485.64 ft	t. /	South Caroli	na	South
ROMAN NUMERALS INDICATE WHETH OR (IV) WASHINGTON OFFICE.	HER THE ITEM IS TO BE ENTER	RED BY (ti) F	IELD PARTY, (III) P	HOTOGRAMME	TRIC OFFICE,

U.S. DEPARTMENT OF COMMERCE ENVIRONMENTAL SCIENCE SERVICES ADMINISTRATION COAST AND GEODETIC SURVEY

#### **DESCRIPTIVE REPORT - DATA RECORD**

IELD INSPECTION BY (II): Erwest W. H Matthew A.		June 1961
EAN HIGH WATER LOCATION (III) (STATE DA	TE AND METHOD OF LOCATION):	
Air photo compilation		
Date of photography M	arch 13, 1964	
PROJECTION AND GRIDS RULED BY (IV):		DATE
A. E. Roundtree (WO)		Nov. 1964
PROJECTION AND GRIDS CHECKED BY (IV):		DATE
P. Hawkins (WO)		Nov. 1964
CONTROL PLOTTED BY (III):		DATE
A. Santillan	Jan. 1965	
ONTROL CHECKED BY (III):		DATE
H. Cordell		Jan.1965
ADIAL PLOT OR STEREOSCOPIC CONTROL E L. Fritz (WSC)	EXTENSION BY (III):	DATE
J. T. Gerlach (WSC)	ii): PLANIMETRY	No date
FEREOSCOPIC INSTRUMENT COMPILATION (	B. Wilson	May 1966
o	CONTOURS Inapplicable	DATE
IANUSCRIPT DELINEATED BY (III):	· · · · · · · · · · · · · · · · · · ·	DATE
B. Wilson		May 1966
CRIBING BY (III):		DATE
		DATE
PHOTOGRAMMETRIC OFFICE REVIEW BY (III):		DATE
B. Wilson		May 1966

U.S. DEPARTMENT OF COMMERCE ENVIRONMENTAL SCIENCE SERVICES ADMINISTRATION COAST AND GEODETIC SURVEY

RATIO OF

RANGES

MEAN

RANGE

6.9

SPRING

RANGE

82

# **DESCRIPTIVE REPORT - DATA RECORD**

CAMERA (KIND OR SOURCE) (III):

FERENCE STATION:

#### W Camera

64 W 4286 March 13,1964 0936 1:30,000 5.2 5.2 5.2	E OF TIDE
4287 " 0937 " 5.2	
1,287 " 0937 " 5.2	
1 +00	
ц288 п 0938 п 5.2	
7,50	
4 W 4314 " 1003 " 3.7	
4315 " 1003 " 3.7	
4316 " 1004 " 3.7	
4317 1 1004 1 3.7	
4318 7 1005 7 3.7	

TIDE (III) Predicted

BORDINATE STATION: FRIPPS INLET, HUNTING IS	SLAND, S	.c.		6.2	7.3
SUBORDINATE STATION:	<del></del>	_			
Atlantic Marine Center  WASHINGTON REVIEW BY (IV): C. H. Bisl	hop		DATE:	-28-71	<u></u>
PROOF EDIT BY (IV):			DATE:		
NUMBER OF TRIANGULATION STATIONS SEARCHED FOR (II):	12	RECOVERED:	IDENTIFI	ED:	
NUMBER OF BM(S) SEARCHED FOR (II):	None	RECOVERED:	IDENTIF	ed one	

NUMBER OF RECOVERABLE PHOTO STATIONS ESTABLISHED (III):

None

NUMBER OF TEMPORARY PHOTO HYDRO STATIONS ESTABLISHED (III):

None

REMARKS:

l new triangulation station established, namely, PORT ROYAL ENTRANCE CHANNEL FRONT RANGE LIGHT, 1964. It was not identified on the photographs.

This station falls to the east of the limits of the map manuscript.

SAVANNAH RIVER ENTRANCE, GA.

R.E.S.

# T-12619

COMPILATION RECORD COMPILATION DATE

REMARKS

Alongshore area for hydro	May 1966	
Compilation complete pending Field Edit	May 1966	
Final Review	June 1971	
·		
÷		

#### SUMMARY TO ACCOMPANY

#### DESCRIPTIVE REPORT T-12619

This shoreline manuscript, scale 1:20,000, is one of 18 maps that comprise Project PH-6407, Charleston, South Carolina, to Savannah, Georgia. The sketch on page 5 of this report shows the location of T-12619 in the project.

Compilation was by stereo-instrument. All of the photographs for T-12619 are 1:30,000 scale panchromatic, taken on March 13, 1964. The stereo-bridge was run and adjusted to field identified control in the Rockville Science Center. Compilation was done with the Kelsh Plotter in the Atlantic Marine Center in May 1966. Ratio prints of the compilation photography at 1:20,000 scale were prepared for photo-hydro support, but hydrography was not accomplished as of June 1971.

Field work before compilation consisted of field identification of control and field inspection. This map was not field edited.

Final review was done at the Atlantic Marine Center in June 1971.

The compilation manuscript was a vinylite sheet 7 1/2 minutes in latitude by 7 1/2 minutes in longitude.

A cronaflex copy of the final reviewed manuscript and a negative have been forwarded for record and registry.

# FIELD INSPECTION REPORT Project 21420 (Part 2) Maps T-12613 thru T-12621 Georgia and South Carolina

This report is submitted for nine Shoreline Maps since there are no great differences in terrain, natural or cultural features which would require special treatment.

# 2. AREAL FIELD INSPECTION

The area lies between Savannah River and Northeastward to a point just South of Edisto Beach. It includes the outside shoreline and a part of Savannah River, Port Royal Sound and St. Helena Sound. The photograph coverage is not complete for each map, therefore, in accordance with instructions from Washington, field inspection has been completed to the limits of the photographs.

The portion bordering the Atlantic Ocean consists of high sand dunes along the ocean with marsh and swamp behind.

The town of Savannah is located just West of the most Southern maps whereas the town of Beaufort is centrally located. Most of the land is owned by private interests and in many cases, special permission is required to enter the properties.

The photographs were taken in the spring of 1964. The photographic quality was good for the entire area. The tones were found to be similar to other areas along the South Atlantic Coast.

Photographs used for field inspection are listed below by individual maps:

<u>T-12613</u>	T-12614	<u>T-126</u>	15		T-12616	T-12617	<u>T-12618</u>
64-W-4269	64-S-1202	64-W-4298			64-W-4279	64-W-4271	64-W-4319
4270	1203	4289	thru	4291	thru	thru	thru
64-S-1206		4307	thru	4311	4283	4273	4320

T-12619
T-12620
T-12621

64-W-4315 thru 64-W-4318 64-W-4324 thru 64-W-4327 64-W-4321 thru 64-W-4323 4286 thru 4288 4329 thru 4334 4335 thru 4337

#### HORIZONTAL CONTROL

Horizontal Control recovery and identification has been completed in accordance with Project Instructions.

The identification of horizontal control was accomplished on enlarged sections of the photographs. This was the first time our party had used the enlarged sections for this purpose. In most cases there was no difficulty and it is believed that the substitute points selected enhanced the accuracy and quality of the points. However, there was difficulty at one station (VENUS 2). The station was pricked direct as there was a small steel stand

over the mark. The substitute point could only be seen good on two of the four photographs. This point has been marked doubtful.

Horizontal control stations reported "lost", "destroyed", or "not recovered" are listed below by map:

# T-12613

ASH 1919 BEK (BEACON NO 1), 1934 BUTCHERS ISLAND 1857 CENTRAL 1913 COMBAHEE BANK LIGHT 1955 EGG 4, 1933 EGG BANK PASSAGE DAYBEACON All, 1955 EGG BANK PASSAGE DAYBEACON A9, 1955 EGG BANK PASSAGE DAYBEACON A7, 1955 EGG BANK PASSAGE DAYBEACON A5, 1955 EGG BANK PASSAGE DAYBEACON A4, 1955 GREEN BEACON 1933 GUS (BEACON NO 2) 1934 HARBOR RIVER DAYBEACON A14, 1955 HUTCHINSON 2, 1933 PALMETTO 1933 PELICAN BANK DAYBEACON A2, 1955 PELICAN BANK DAYBEACON A1, 1955 RED BEACON 1933 SOUND 1933 WHARF 1933

# T-12614

ED 1921

# T-12615

ARCH 1921 ARCHE CREEK BEACON 1933 BASE 1 (USE) 1931 BEAUFORT RIVER LIGHT 17, 1955 BEAUFORT RIVER LIGHT 13A, 1955 BUC 1933 BROOKLYN 1859 CHOW 1933 FORT FREMONT OBSERVATION TOWER 1931 DOS 1931 FORT FREMONT BEACON 1931 NORTH 1931 PARRIS ISLAND WATER TANK (WHITE WITH BLACK TOP)1932 PARRIS ISLAND, LOW WHITE STACK 1932 PARRIS ISLAND SILVER WATER TANK 1932

PARRIS ISLAND MARINE CORPS RECRUIT DEPOT AIR STRIP BEACON 1955

PARRIS ISLAND HIGH BRICK STACK 1932

PARRIS ISLAND STACK (HIGHEST OF TWINS) 1932

PARRIS ISLAND MARINE CORPS, RECRUIT DEPOT, AIR CONTROL TOWER 1955
PARRIS (USE) 1931
PORT ROYAL SOUND LIGHT NO 1, 1955
SKULL CREEK DAYBEACON 4, 1955
SKULL CREEK ENTRANCE LIGHT 3, 1955
SKULL CREEK DAYBEACON 5, 1955
SPIT 1933
TRIANGULAR BEACON 1931

# T-12616

BULL 1933 MID 1931 TIDE 1933

# T-12617

STORY RIVER DAYBEACON A16, 1955 TEMPORARY 1955

# T-12618

BACK 1931
BULLPOINT FRONT RANGE 1931
BUCK 2, 1931
FRON 1931
MAG 1931
MARSH 2, 1931
MARTIN 1933
NO 9 (USE) 1931
OCHO 1921
SIETE 1931
SOUTH 1931
UIMER 1933

# T-12619

HILTON FRONT 1931 STONEY PLANTATION, BAPTIST CHURCH 1931 TON 1931 TON 2, 1955 WAL 3, 1955

# T-12620

BARNWELL PLACE LIGHT (OGLETHORPE REAR RANGE LIGHT) 1913
BLOODY 1932
BUSH (USE) 1932
ELBA ISLAND FLATS, LIGHT NO 11, 1932
FIELDS CUT NO 1 (USE) 1932
LOWER FLATS REAR RANGE LIGHT 1932
LAZAGETTO CREEK HIGHWAY BRIDGE CENTER OF SWING SPAN 1932
LONG ISLAND CROSSING FRONT RANGE LIGHT 1933

LONG ISLAND CROSSING REAR RANGE LIGHT 1933 NEW CHANNEL REAR RANGE LIGHT 1932 NORTH CORNER OF OLD TOWER 1932 PERRY (USE) 1934 PALMETTO 1933 QUARANTINE TANK FINIAL 1932 QUARANTINE (USE) 1932 TOPO 1934 TYBEE KNOLL CUT FRONT RANGE LIGHT 1932 UPPER FLATS FRONT RANGE TARGET 1932 UPPER FLATS REAR RANGE LIGHT 1932 WALLS CUT BEACON NO 6, 1932 WALLS CUT BEACON NO 8, 1932 WILMINGTON 1857 WILMINGTON ISLAND BLACK VENTILATOR, OGIETHORPE HOTEL 1933 WRIGHT 1932

# T-12621

BRAD 1931 DO 1916 FORT SCREVEN WATER TANK 1932 SAVANNAH BEACH, CASINO SOUTH COPOLA 1913 SAVANNAH BEACH, CASINO NORTH COPOLA, 1913 TYBRISA TANK 1932

# 4. VERTICAL CONTROL

A search was made for all tidal bench marks within the limits of these maps. Form 685A was submitted for each mark. One mark in each group was identified on the photograph, except in a few cases where there was no coverage.

#### 5. CONTOURS AND DRAINAGE

Contours are inapplicable.

Drainage is almost entirely composed of tidal streams. Normal drainage is generally by direct run-off into marsh, swamp or the tidal streams.

# WOODLAND COVER

Woodland Cover was classified in accordance with the Topographic Manual.

# 7. SHORELINE AND ALONGSHORE FEATURES

The high-water line has been indicated on the photographs by symbol in accordance with current instructions. No attempt was made to delineate the low-water line.

The field inspector accomplished this phase by several methods; Measurements from identifiable points of detail, by visual inspection from skiff, and by walking the shoreline.

All other shoreline features are adequately covered by field inspection notes on the photographs. The photography is recent, therefore, there have been no great changes.

# 8. OFFSHORE FEATURES

Several piling etc. were located either by sextant fix or theodolite cuts during this survey.

The obstruction reported at Lat. 32-01 - Long. 80-50 chart 1240, could not be seen at low-water.

Your attention is invited to the restricted area in Broad River, near Archers Creek. It is believed that the restricted area should be enlarged on the charts since most of this portion of the river is under fire by the marine guns.

# 9. LANDMARKS AND AIDS

All Nautical Landmarks have been investigated in the field and are reported on form 567.

All fixed Aids to Navigation were investigated and are reported on form 567. Third-order positions were obtained for the following:

TYBEE KNOLL CUT RANGE REAR LIGHT, 1964
TYBEE RANGE FRONT LIGHT, 1964
JONES ISLAND RANGE FRONT LIGHT, 1964
PORT ROYAL ENTRANCE, CHANNEL FRONT RANGE LIGHT, 1964

Four private aids in the Calibogue Sound area are recommended for charting. The aids were located by several methods; Cuts from triangulation stations and photo points, by sextant fixes, or identified directly on the photograph.

# 10. BOUNDARIES, MONUMENTS AND LINES

There have been no boundary lines shown.

#### 11. OTHER CONTROL

There were no topographic stations established.

# 12. OTHER INTERIOR FEATURES

All roads were classified in accordance with Photogrammetry Instructions number 56.

Field Inspection of buildings was done in accordance with Photogrammetry Instructions Number 54, revised September 22, 1961.

There were no bridge or cable clearances measured during this survey.

Marsh and Swamp limits have been shown on the photographs where coverage was available.

# 13. GEOGRAPHIC NAMES

The investigation of Geographic Names will be handled slightly different from that called for in Project Instructions. This change in procedure was recommended by Dr. A. J. Wraight, Chief, Geographic Names Branch.

A systematic and complete investigation of Geographic Names wasmade from Savannah River North and East to Latitude 32-15. The remainder of the project will be investigated for discrepancies and New Names only.

The change in procedure is due to the recent investigation of names in the project during the years 1955, 1956 and 1957.

The Geographic Names Reports will be submitted at a later date.

# 14. SPECIAL REPORTS AND SUPPLEMENTAL DATA

Transmitting letters for Horizontal Control Identification were mailed to Washington separately for Part 1 and Part 2 of the Project. Part 1 was mailed on 10 July 1964 and Part 2 on 7 July 1964.

Form 567 will be forwarded with this report.

17 July 1964 Submitted by:

Joseph K. Wilson

Chief, Photo Party 6420

# Aerotriangulation Report

Project No. 21420

Charleston, South Carolina to Savannah, Georgia

# 21. Area Covered

The bridging covers the Atlantic Coast Shoreline of an areas between Charleston, South Carolina to Savannah, Georgia.

# 22. Method

Nine strips were bridged on the Zeiss C-5 and C-9 stereoplanigraphs to provide control for compilation of shoreline.

Strip No.	Photos
1 94 56 78 90	64s 1206 - 1227 64w 4269 - 4273 .64w 4276 - 4284 64w 4306 - 4312 64w 4296 - 4302 64w 4290 - 4294 64w 4314 - 4327 64w 4332 - 4337 64w 4286 - 4290

Strip #2 consisting of photos 64S 1184 - 1203 was not bridged. However, tie points were dropped from Strip #1 to provide control for graphic compilation of the area.

All strips were 1:30,000 scale photography.

# 23. Adequacy of Control

Control positions were adequate for bridge adjustment. However, the northeast end of Strip #1 was run as a separate bridge due to difficulty in holding the control. End acquents had control station Hernan in common. He paints between the two bridges were averaged.

Strip #7 was also interrupted due to a water gap and divided into two bridges, #7 and #10.

Samin (7) was ended at control station Queen because Succious Province (138) would not hold. This was probably eas be a control for the was probably eas be a control for the control of t

All other points held within accuracy requirements.

All common pass points between the strips were averaged.

# 24. Supplemental Data

A number of objects identified as landmarks were used as check control stations and held within accuracy requirements.

# 25. Photography

Photography was adequate as to coverage, overlap and definition.

# 26. Recommendations

Ratio prints of Strip #2, at a scale of 1:20,000, have been ordered and will be submitted separately.

Submitted by:

176 2F

Laurence Fritz John T. Gerlash

Approved by:

John D. Perrow, Jr.


Aerotriangulation Report
Project No. 21420
Charleston, S.C. to Savannah, Ga.


Amendment to Report of Nov. 1964

Strip 9-A, consisting of photos 64-W-4329 through 4332, was bridged using three triangulation stations as control. Station Proctor Use, 1932 (SS #1) was of very poor image quality and could not be held in the bridge. A secondary straight line adjustment was applied to the junction area of Strips 8 and 9. This junction is weak but within National Map Accuracy Standards.

Submitted by:

John D. Perrow, Jr.

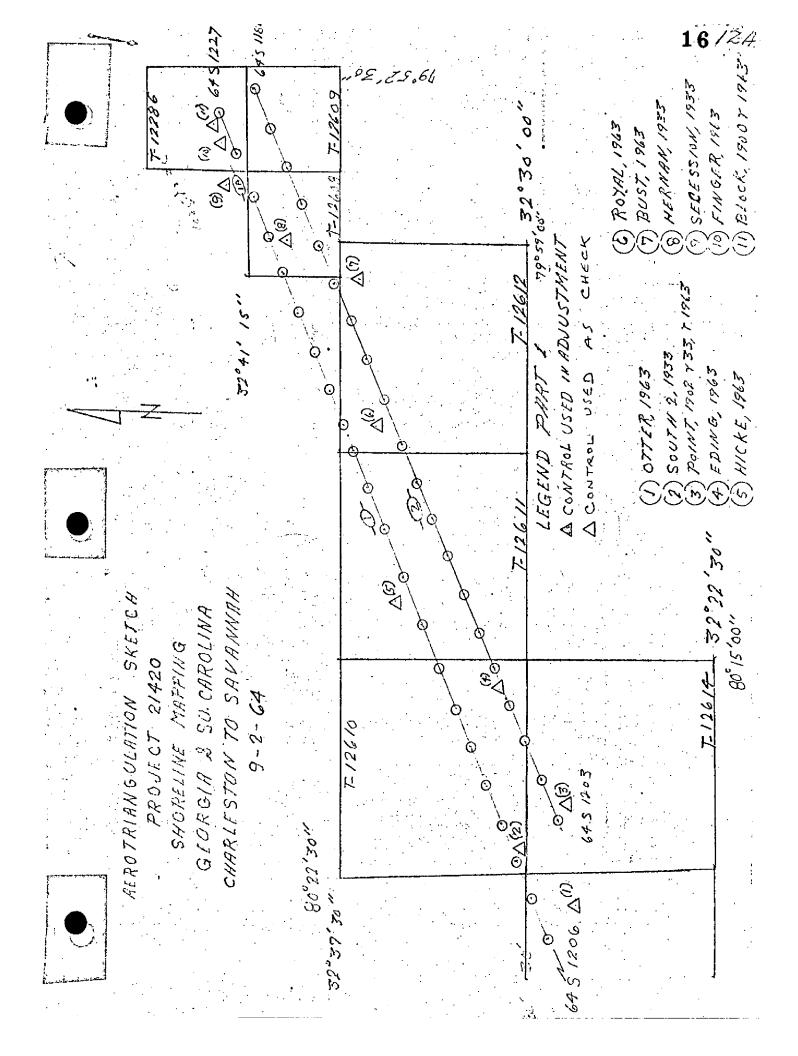

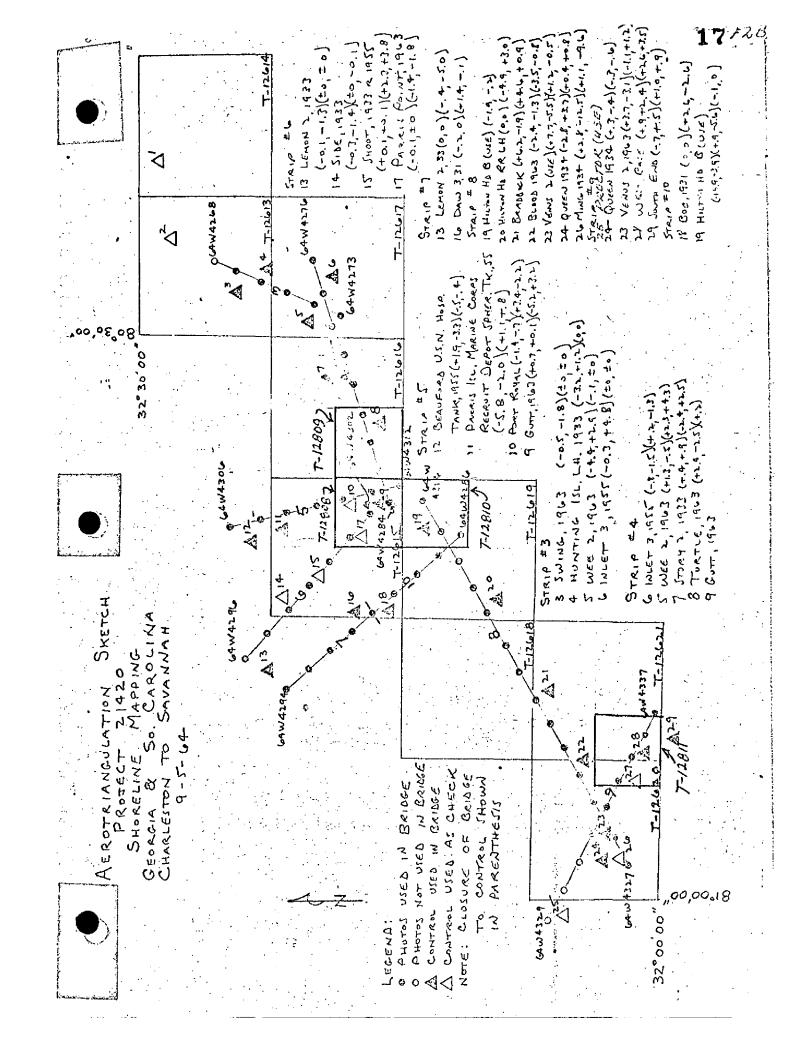

PROM GRID OR PROJECTION LINE FROM GRID OR PROJECTION LINE IN METERS 1 8 M-2388-12 (BACK) FORWARD SCALE FACTOR ..... 2-2-65 (BACK) N.A. 1927 - DATUM FORWARD DATUM OR PROJECTION LINE IN METERS BEB DISTANCE FROM GRID IN FEET, (BACK) 21420 (PH-6407) SCALE OF MAP CHECKED BY:.. 1117.11234.2 (613.9) FORWARD 455.0 LONGITUDE OR x-COORDINATE LATITUDE OR y-COORDINATE 320 091 51,300" 80° 44° 24.759" 32° 091 40.070" 80° 481 17.366" 12-28-64 2,080,399.72 2,101,770.93 120,505.49 120,468.02 2,080,395.02 146,348.07 2,099,648.86 2,101,736.76 2,080,387,27 2,078,485.64 141,784.14 150,519.74 139,164,27 PROJECT NO. DATE DATUM GPs p.310 N.A. = = PCs S p.112" = Ξ GPs p.113 GPs p.118 PCs S p.45 PCs S p.42 GPs p.111 unadjusted unadjusted P Vol III Form 280 Form 28D SOURCE OF INFORMATION p. 421 (INDEX) PC Same page BLB MAP T. 12619 HILTON HEAD REAR 1908E LIGHTHOUSE HILTON HEAD REAR RANGE LIGHTHOUSE RM 1, 1964 1 FT. = 3048006 METER HILTON HEAD B (USE), 1955 STATION BENCH MARK COMPUTED BY:... GRAVE, 1931 WAL 4, 1955 К 11 1964 HEAD, 1963 TON, 1931 =

1:20,000

#### COMPILATION REPORT

# T-12619

# 31. DELINEATION

The Kelsh plotter was used. Field inspection was adequate. Photography was satisfactory.

# 32. CONTROL

See Aerotriangulation Report dated November 1964.

# 33. SUPPLEMENTAL DATA

None

# 34. CONTOURS AND DRAINAGE

Contours are inapplicable.

Drainage was delineated as inspected or from office interpretation of the photography.

# 35. SHORELINE AND ALONGSHORE DETAILS

Shoreline inspection was adequate.

The low water line was delineated from office interpretation of the photography.

# 36. OFFSHORE DETAILS

No statement

# 37. LANDMARKS AND AIDS

Landmarks and aids were listed on Form 567 and forwarded to the Washington Office under date May 31, 1966.

# 38. CONTROL FOR FUTURE SURVEYS

none

# 39. JUNCTIONS

Junctions were made with T-12618 to the west and T-12615 to the north. The Atlantic Ocean is to the south and east.

# 40. HORIZONTAL AND VERTICAL ACCURACY

No statement

# 46. GOMPARISON WITH EXISTING MAPS

Comparison has been made with U.S.G.S. Quadrangle HILTON HEAD, S. C., scale 1:24,000, dated 1956.

# 47. COMPARISON WITH NAUTICAL CHARTS

Comparison has been made with Chart 571, scale 1:40,000, 12th edition, dated November 21, 1960, revised April 1, 1963.

The town of Forest Beach did not appear on the chart.

# ITEMS TO BE APPLIED TO NAUTICAL CHARTS IMMEDIATELY

None

# ITEMS TO BE CARRIED FORWARD

None

Respectfully submitted:

Bernice Wilson

Cartographic Technician

Bernice Wilson

Approved:

Allen L. Powell, RADM, NOAA

Director, Atlantic Marine Center

GEOGRAPHIC NAMES

FINAL NAME SHEET

PH-6407 (South Carolina)

T-12619

Atlantic Ocean Bass Head Broad Creek Coggins Point Fish Haul Creek Forest Beach Hilton Head Hilton Head Island Intracoastal Waterway Joiner Bank Lighthouse Landing Port Royal Plantation Port Royal Sound Scarborough Head Skull Creek The Folly Whooping Crane Pond

Approved by:

A. Joseph Wraight

Chief Geographer

Prepared by:

Frank W. Pickett

Cartographic Technician

# T-12619

# 49. NOTES FOR THE HYDROGRAPHER

No photo hydro stations were located but shoreline pass points were established for photo-hydro support.

The check angle for SKULL CREEK DAYBEACON 10, 1964 could not be held. Please verify position.

USCOMM-DC 18252-P61

C&G5 FORM 1002 (11-13-61)			· , U.	S. DEPARTMENT OF COMMERC COAST AND GEODETIC SURVE
	PHO		RIC OFFICE REVIEW	
1. DDG LECTION AND CRIDE	2 TITLE	[*]	12619	4. MANUSCRIPT SIZE
I. PROJECTION AND GRIDS			•	1
BM	BW ·		₽₩	BW
CONTROL STATIONS				
5. HORIZONTAL CONTROL ST THIRD-ORDER OR HIGHER A BW	ACCURACY	OF LESS TH	BLE HORIZONTAL STATIONS IAN THIRD-ORDER ACCURACY c stations)	7. PHOTO HYDRO STATIONS
8. BENCH MARKS	9. PLOTTING	OF SEXTANT	10. PHOTOGRAMMETRIC PLOT REPORT	11. DETAIL POINTS
BW	BW		BRIDGE (WSC)	KELSH
ALONGSHORE AREAS (Nautica	l Chart Data)			<u> </u>
12. SHORELINE	13. LOW-WATE	R LINE .	14. ROCKS, SHOALS, ETC.	15. BRIDGES
₽₩	BW		. BW	
16. AIDS TO NAVIGATION	17. LANDMARK	(S	18. OTHER ALONGSHORE PHYSICAL FEATURES	19. OTHER ALONGSHORE CULTURAL FEATURES
<b>BW</b>	BW		BW	BW
PHYSICAL FEATURES				
20. WATER FEATURES		21. NATURAL	GROUND COVER	22. PLANETABLE CONTOU
BW			BW	XX
23. STEREOSCOPIC INSTRUMENT CONTOURS	24. CONTOUR	IN GENERAL	25. SPOT ELEVATIONS	26. OTHER PHYSICAL FEATURES
XX	XX	•	XX	BW
CULTURAL FEATURES				
27. ROADS	28. BUILDINGS	5	29. RAILROADS	30. OTHER CULTURAL FEATURES
<b>BW</b>	BW		XX	BW
BOUNDARIES 31. BOUNDARY LINES			32. PUBLIC LAND LINES	
XX			XX.	
MISCELLANEOUS 33. GEOGRAPHIC NAMES		34. JUNCTION	\$	35. LEGIBILITY OF THE
BM WANTED		Jan Some Hon	· •	MANUSCRIPT
			BW	
36. DISCREPANCY OVERLAY	37. DESCRIPTI	VE REPORT	38. FIELD INSPECTION PHOTOGRAPHS	39. FORMS
-	BW		B₩	HW
40, REVIEWER		٠, ٥	SUPERVISOR, REVIEW SECTIO	N OR UNIT
Bernice Wilson Bo	mice M	) User	ACR	
41. REMARKS (See attached she				
FIELD COMPLETION ADDITIO				· · · · · · · · · · · · · · · · · · ·
<ol> <li>Additions and correction script is now complete ex</li> </ol>	s furnished by the cept as noted un	ie field complet der item 43.	ion survey have been applied t	o the manuscript. The manu-
COMPILER			SUPERVISOR	
			1	
43. REMARKS			<u> </u>	·
				•

NT OF COMMERCE **SDETIC SURVEY** D.S. DEPAR

# NONFLOATING AIDS OR L'ANDMARKS FOR CHARTS

STRIKE OUT TWO TO BE CHARTED 10-94-9ELETED TO DE REVISED

ATLANTIC MARINE CENTER

MAY 5

9

I recommend that the following objects which have (fare not) been inspected from seaward to determine their value as landmarks be charted on (dalatad-from) the charts indicated.

The positions given have been checked after listing by

J. Bull, Director, Atlantic Marine Center B. Wilson

CHARTING		,						METHOD		_	YM:
CHARTING			E Y	LATITUDE	LONG	LONGITUDE +		LOCATION	0A77		CHARTS
	DESCRIPTION	SIGNAL	•	D. M. M.ETEDS	•	D. P. METERS	DATUM	BURVEY No.	LOCATION	PRIVIT	19440
	INTRACOASTAL MATERWAY	,									,
LIGHT 8			32 15	151	80 1,5	13.75	N937	Photo. 5-29	5-29-64 N.of	×	1240
DAYEN 9	£		32 JL	58.99	80 45	८गट गग <sup>-</sup> 6	22	*	E	×	#
DAYEN 10			32 Jh	38 37 1182	80 45	1.38 36		E	=	×	E
DAYEN 11				33.08	80 1.1	1875	Į.	T-12619	E	<b>X</b>	8
DAYEN 13			32 14	क्ष प्र	ς π	2.37	=	T-12618	<b>E</b>	×	=
	<u>\$</u>										
1.	1										
	1										
											2
		•									3

USCOMMOC 16234-P61 The data should be inis form shall be prepared in accordance with hydrographic Manual, Fublication 20.2, Sec. 1-72, 2-73, 0-75, 7-15 to 22 inclusive, and Fig. 7.
|andmarks and nonfloating aids to navigation, if redetermined, shall be reported on this form. Revisions shall show both the old and new positions. considered for the charts of the area and not by individual field survey sheets. Information under each column heading should be given. \* TABULATE SECONDS AND METERS

#### REVIEW REPORT T-12619

#### SHORELINE

June 28, 1971

#### 61. GENERAL STATEMENT:

See Summary on page 6 of this Descriptive Report.

An ozalid comparison print, pages 26through 30, with differences noted in Items 62, 63, and 65, is bound with the original of this report.

# 62. COMPARISON WITH REGISTERED TOPOGRAPHIC SURVEYS:

A comparison was made with Survey T-5135, scale 1:20,000, compiled from aerial photographs taken in 1933. Differences between this survey and T-12619 are shown in blue on the comparison print.

Skull Creek, at the northwest corner of the map, is not covered by T-5135.

T-12619 supersedes T-5135 for charting purposes and will be superseded by TP-00272, TP-00276 and part of TP-00279, when they are completed.

# 63. COMPARISON WITH MAPS OF OTHER AGENCIES:

A comparison was made with U.S.G.S. Quadrangle HILTON HEAD, S.C., scale 1:24,000, dated 1956. Differences between this map and T-12619 are shown in brown on the comparison print.

There are discrepancies of as much as 0.6 mm (120 meters) in the shoreline bordering the Atlantic Ocean. See Comparison Print.

# 64. COMPARISON WITH CONTEMPORARY HYDROGRAPHIC SURVEYS:

No contemporary hydrographic surveys were available for comparison.

# 65. COMPARISON WITH NAUTICAL CHARTS:

A comparison was made with Chart 571, scale 1:40,000, 16th edition, dated October 31, 1970. Differences between this chart and T-12619 are shown in red on the comparison print.

# 66. ADEQUACY OF RESULTS AND FUTURE SURVEYS:

This survey complies with Project Instructions, Bureau requirements, and the National Standards for Map Accuracy. No accuracy tests were run in the field.

Reviewed by:

Charles H. Bishop

Charles H. Bishop Cartographer June 28, 1971

Approved for forwarding:

Telvin J. Jumpach, CDR, NOAA

Chief, Photogrammetry Division, AMC

Approved:


Allen L. Powell, RADM, NOAA


Director, Atlantic Marine Center


Approved:


Chief, Photogrammetric Branch Chief


Jack E. Luth Chief, Division of Photogrammetry

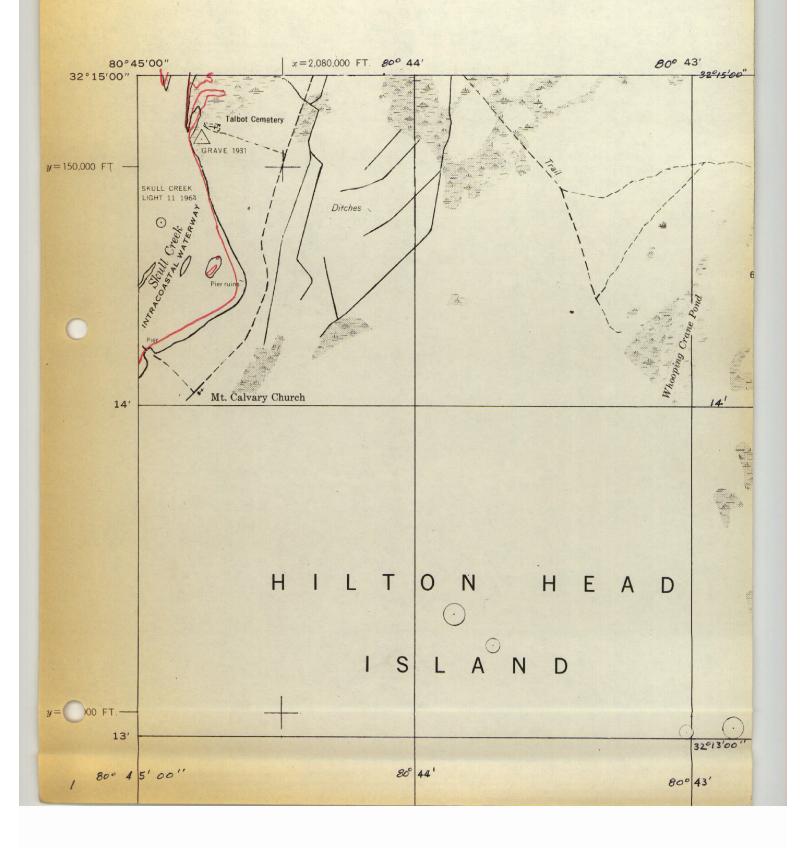

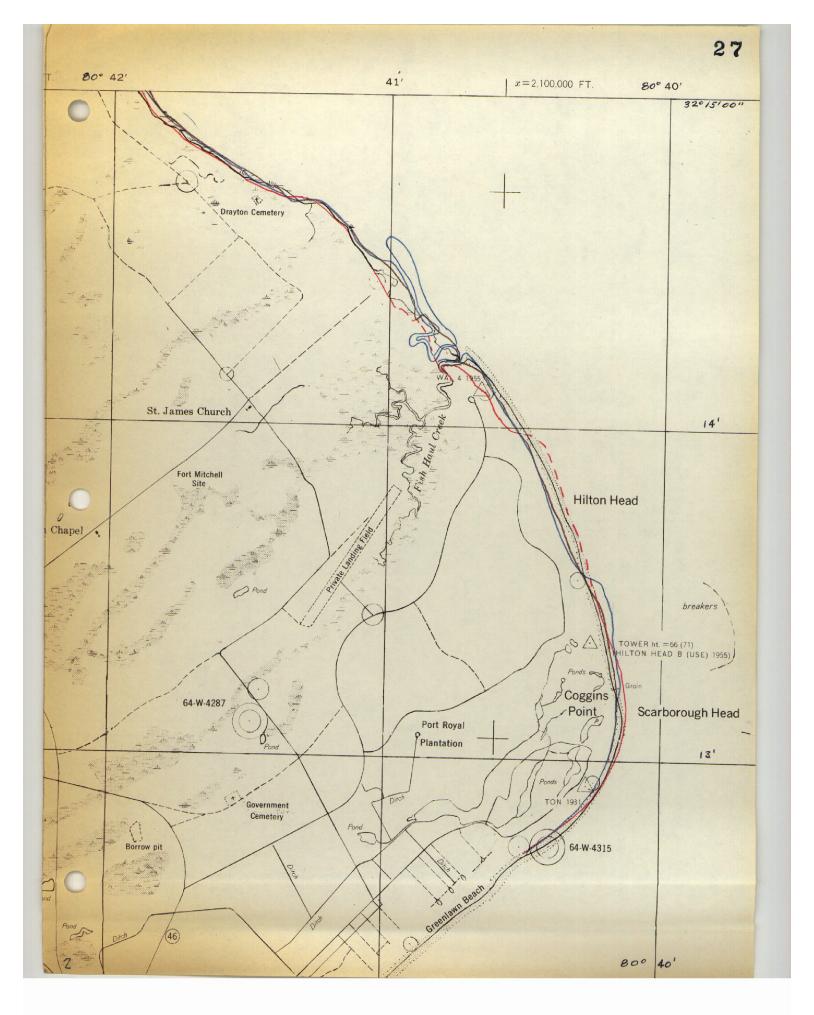

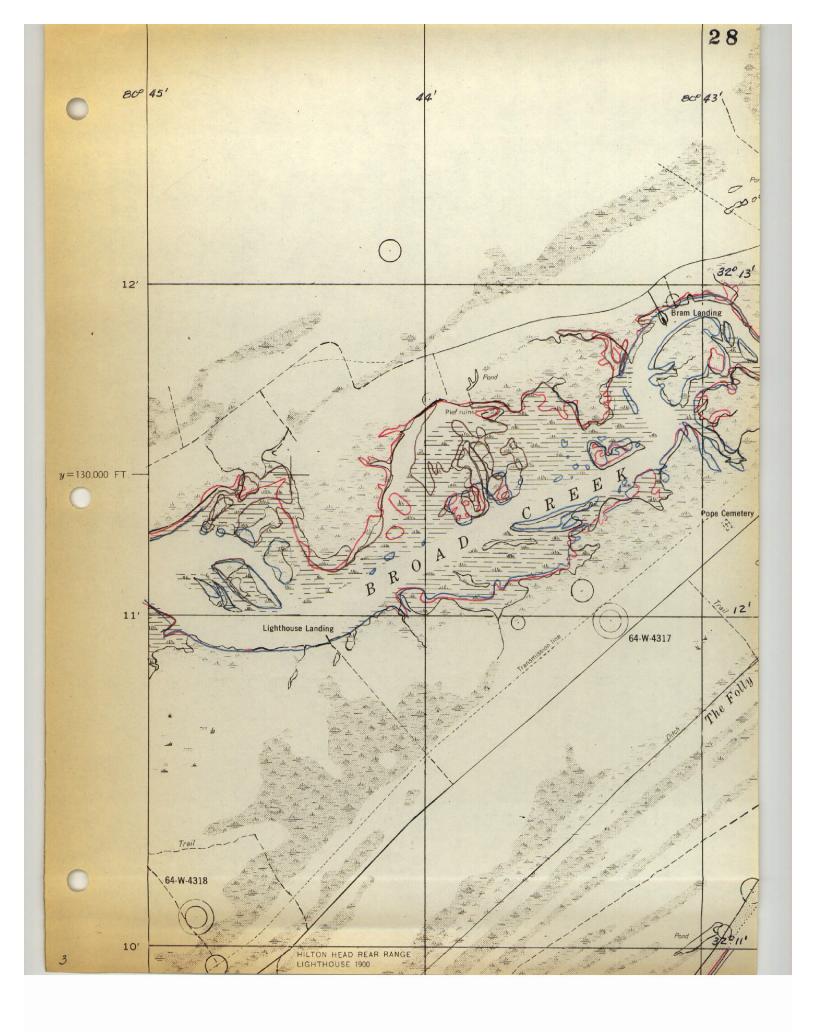

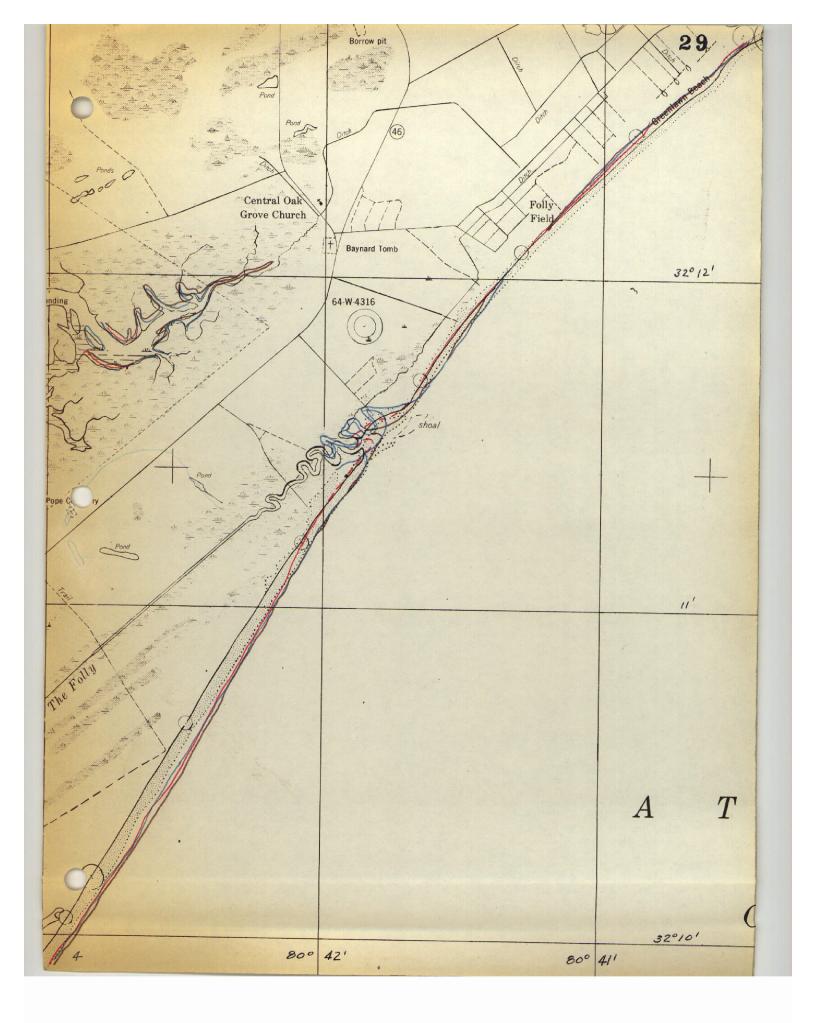

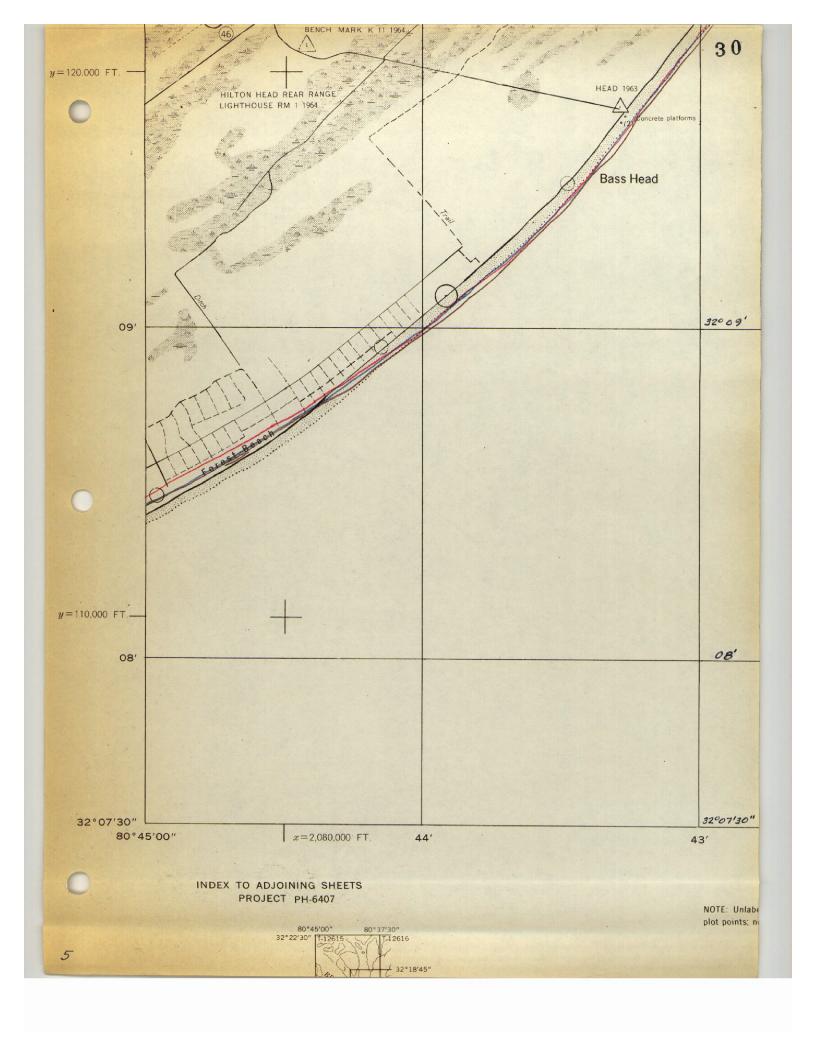

# NAUTICAL CHART DIVISION

# **RECORD OF APPLICATION TO CHARTS**

FILE WITH DESCRIPTIVE REPORT OF SURVEY NO.

#### INSTRUCTIONS

A basic hydrographic or topographic survey supersedes all information of like nature on the uncorrected chart.

1. Letter all information.

2. In "Remarks" column cross out words that do not apply.

3. Give reasons for deviations, if any, from recommendations made under "Comparison with Charts" in the Review.

CHART	DATE	CARTOGRAPHER	REMARKS
239	2-4-72	Unlier	Part Before After Verification Review Inspection Signed Via
			Drawing No.
571	11/17/11	2/ Soland	-Full Part Before After Verification Review Inspection Signed Via
	1.7.	m wany	Drawing No. 20. Part Appid down to last of time in repre
440	4-26-72	@ 0 2.00:	Full Part Before After Verification Review Inspection Signed Via
770	7 00 17		Drawing No. 34 No Correction
440	10-18-74	DL Potiline	Full Part Before After Verification Review Inspection Signed Via
			Drawing No. 37 From No (Appedien)
			Xiperadod by tp 00272
			Full Part Before After Verification Review Inspection Signed Via
			Drawing No.
			Full Part Before After Verification Review Inspection Signed Via
- 30, 6-2			Drawing No.
			Full Part Before After Verification Review Inspection Signed Via
			Drawing No.
			Full Part Before After Verification Review Inspection Signed Via
			Drawing No.
			Full Part Before After Verification Review Inspection Signed Via
			Drawing No.
			Full Born Before Afre W. if.
			Full Part Before After Verification Review Inspection Signed Via
			Drawing No.
-			