

U. S. DEPARTMENT OF COMMERCE COAST AND GEODETIC SURVEY

### DESCRIPTIVE REPORT

Type of Survey SHORELINE (Photogrammetric) Field No. Office No. T-12811

### LOCALITY

State SOUTH CAROLINA - GEORGIA

General local ARLESTON, S. C. TO SAVANNAH, GA.

SAVANNAH BEACH Locality ...

### 19.64-65

CHIEF OF PARTY
Joseph K. Wilson, Chief, Photo Party 6420 Allen L. Powell, Director, A. M. C.

LIBRARY & ARCHIVES

USCOMM-DC 5087

U.S. DEPARTMENT OF COMMERCE ENVIRONMENTAL SCIENCE SERVICES ADMINISTRATION COAST AND GEODETIC SURVEY

	ESCRIPTIVE REPORT - DAT T <sub>-12811</sub>		
PRÓJECT NO. (II):			
Job PH-6407			¢.
FIELD OFFICE (II):		CHIEF OF PARTY	
Beaufort, South Car	lina	Joseph K.	
PHOTOGRAMMETRIC OFFICE (III):		_	
,		OF FICER-IN-CHA	RGE Allen L. Powell
Atlantic Marine Cen			Director
S D	oril 23, 1964 eptember 28, 1964 ecember 22, 1964 ebruary 17, 1971		
METHOD OF COMPILATION (III):  Kelsh			
MANUSCRIPT SCALE (III):	STEREOSC	OPIC PLOTTING IN	STRUMENT SCALE (III):
.10		000 000 P	1 1 1 7 70 000
1:10,000  DATE RECEIVED IN WASHINGTON OFFICE			ohed to 1:10,000
DATE RECEIVED IN WASHINGTON OFFICE	VI.	-OKTED TO NAUTIC	AL CHAR! BRANCH HVI.
,			
APPLIED TO CHART NO.	DATE:		DATE REGISTERED (IV):
GEOGRAPHIC DATUM (III):		VERTICAL DATE	
N.A. 1927	,	1	EL EXCEPT AS FOLLOWS: 1 as (25) refer to mean high water
		- f	as (5) refer to sounding datum
		i.e., mean low wa	iter or mean lower low water
		ļ	
REFERENCE STATION (III):			·
			•
WEST BASE (USE) 193	<del></del>		
	NG.:	X ADJUSTED	
32 01 08.568"(263.9) 8	° 51, 50.032"(13 <b>1</b> 3.0)	TRULDANU	<b>)</b>
PLANE COORDINATES (IV):		STATE	ZONE
/67,594.27 ft. ×=	2,042,189.36 ft.	South Carol	ina South
ROMAN NUMERALS INDICATE WHETHER TO OR (IV) WASHINGTON OFFICE. WHEN ENTERING NAMES OF PERSONNEL C		FIELD PARTY, (III)	PHOTOGRAMMETRIC OFFICE,

FORM C&GS-1816

U.S. DEPARTMENT OF COMMERCE ENVIRONMENTAL SCIENCE SERVICES ADMINISTRATION COAST AND GEODETIC SURVEY



### DESCRIPTIVE REPORT - DATA RECORD

FIELD INSPECTION BY (II):	DATE:
Jim D. Shea	May-June 1964
MEAN HIGH WATER LOCATION (III) (STATE DATE AND METHOD OF LOCATION):	
Air Photo Compilation Date of photography: March 13, 1964	
PROJECTION AND GRIDS RULED BY (IV):	DATE
A. E. Roundtree	1-15-65
PROJECTION AND GRIDS CHECKED BY (IV):	DATE
P. Hopkins	1-15-65
CONTROL PLOTTED BY (III):	DATE
A. Santillan	Jan. 1965
CONTROL CHECKED BY (III):	DATE
H. Cordell	Jan., 1965
RADIAL PLOT OR STEREOSCOPIC CONTROL EXTENSION BY (III):	DATE
L. Fritz (WSC)	
J. T. Gerlach (WSC) STEREOSCOPIC INSTRUMENT COMPILATION (III): PLANIMETRY	DATE
L. Neterer	
r. we deter	July 1965
CONTOURS	DATE
Inapplicable	
MANUSCRIPT DELINEATED BY (III):	DATE
L.Neterer	July, 1965
SCRIBING BY (III):	DATE
PHOTOGRAMMETRIC OFFICE REVIEW BY (III):	DATE
	April 1966
R. J. Pate	



U.S. DEPARTMENT OF COMMERCE ENVIRONMENTAL SCIENCE SERVICES ADMINISTRATION COAST AND GEODETIC SURVEY

### **DESCRIPTIVE REPORT - DATA RECORD**

AMERA (KIND OR SOURCE) (III):

"W" Camera

W Odinor d	PHO	TOGRAPHS (III)		
NUMBER	DATE	TIME	SCALE	STAGE OF TIDE
64 W 4334	13 March 1964	1021	1:30,000	3.6
4335	ţı	1022	$\hat{n}$	3.6 3.6 3.6
4336	tt t	1022	11	3.6
4337	tı .	1023	11	3.6
64 w 4324 & 4325	n	1009	n	4.0
				<u> </u>

	Dredicted	1		1
		RATIO OF RANGES	MEAN RANGE	SPRING
REFERENCE STATION: Savannah River Entrance			6.9	8.1
PORDINATE STATION:				
SUBORDINATE STATION:				
TTIENTIC MARINE Center  XXXXXXXXXXXXXXXXXXXXXXXXXXXXXXXXXXX		DATE:	07-15-7	'1
PROOF EDIT BY (IV):		DATE:	·	
NUMBER OF TRIANGULATION STATIONS SEARCHED FOR (II):	RECOVERED:	IDENTIFIE	D:	
NUMBER OF BM(\$) SEARCHED FOR ((1):	RECOVERED:	IDENTIFIE	:D	
NUMBER OF RECOVERABLE PHOTO STATIONS ESTABLISHED (III):	None	<del></del>		

None

REMARKS:

Ò



T-12811

COMPLETION DATE	REMARKS
July 1965	
July 1971	
	July 1965



### SUMMARY TO ACCOMPANY

The Control of the Co

### DESCRIPTIVE REPORT T-12811

This shoreline manuscript, scale 1:10,000, is one of 18 maps that comprise Project PH-6407, Charleston, South Carolina to Savannah, Georgia. The sketch on page 5 of this report shows the location of T-12811 in the project.

This is a stereo-instrument project. All of the photographs for T-12811 were 1:30,000 scale panchromatic, taken with the "W" camera on March 13, 1964. The stereo-bridge was run and adjusted to field identified control at the Rockville Science Center. Compilation was done with the Kelsh Plotter at the Atlantic Marine Center. Ratio prints at 1:10,000 scale were processed for photo-hydro support, but hydrography was not accomplished as of July 1971.

Field work before compilation consisted of control identification and field inspection. This map was not field edited.

Final review was done at the Atlantic Marine Center in July 1971.

The compilation manuscript was a vinylite sheet 3 minutes 45 seconds in latitude by 4 minutes 45 seconds in longitude.

A cronaflex copy of the final reviewed manuscript and a negative have been forwarded for record and registry.

### FIELD INSPECTION REPORT Project 21420 (Part 2) Maps T-12613 thru T-12621 Georgia and South Carolina

This report is submitted for nine Shoreline Maps since there are no great differences in terrain, natural or cultural features which would require special treatment.

### 2. AREAL FIELD INSPECTION

The area lies between Savannah River and Northeastward to a point just South of Edisto Beach. It includes the outside shoreline and a part of Savannah River, Port Royal Sound and St. Helena Sound. The photograph coverage is not complete for each map, therefore, in accordance with instructions from Washington, field inspection has been completed to the limits of the photographs.

The portion bordering the Atlantic Ocean consists of high sand dunes along the ocean with marsh and swamp behind.

The town of Savannah is located just West of the most Southern maps whereas the town of Beaufort is centrally located. Most of the land is owned by private interests and in many cases, special permission is required to enter the properties.

The photographs were taken in the spring of 1964. The photographic quality was good for the entire area. The tones were found to be similar to other areas along the South Atlantic Coast.

Photographs used for field inspection are listed below by individual maps:

T-12613	<u>T-12614</u>	<u>T-12</u>	<u>615</u>	<u>T-12616</u>	<u>T-12617</u>	<u>T-12618</u>
64-W-4269 4270 64-S-1206	64-S-1202 1203	4289	thru 4302 thru 4291 thru 4311	64-W-4279 thru 4283	64-W-4271 thru 4273	64-W-4319 thru 4320
O4-0-12,00		4701	Ulliu AJII	420)	4413	4520

<u>T-12619</u>	<u>T-12620</u>	•	<u>T-12621</u>	
64-W-4315 thru 64-W-431	8 64-W-4324 thru 6	54-W-4327 64	-W-4321 thru	64-W-4323
<b>42</b> 86 thru	8 4329 thru	<b>4</b> 334	4335 thru	4337

### 3. HORIZONTAL CONTROL

Horizontal Control recovery and identification has been completed in accordance with Project Instructions.

The identification of horizontal control was accomplished on enlarged sections of the photographs. This was the first time our party had used the enlarged sections for this purpose. In most cases there was no difficulty and it is believed that the substitute points selected enhanced the accuracy and quality of the points. However, there was difficulty at one station (VENUS 2). The station was pricked direct as there was a small steel stand

over the mark. The substitute point could only be seen good on two of the four photographs. This point has been marked doubtful.

Horizontal control stations reported "lost", "destroyed", or "not recovered" are listed below by map:

### <u>T-12613</u>

ASH 1919 BEK (BEACON NO 1), 1934 BUTCHERS ISLAND 1857 CENTRAL 1913 COMBAHEE BANK LIGHT 1955 EGG 4, 1933 EGG BANK PASSAGE DAYBEACON All, 1955 EGG BANK PASSAGE DAYBEACON A9, 1955 EGG BANK PASSAGE DAYBEACON A7, 1955 EGG BANK PASSAGE DAYBEACON A5, 1955 EGG BANK PASSAGE DAYBEACON A4, 1955 GREEN BEACON 1933 GUS (BEACON NO 2) 1934 HARBOR RIVER DAYBEACON A14, 1955 HUTCHINSON 2, 1933 PALMETTO 1933 PELICAN BANK DAYBEACON A2, 1955 PELICAN BANK DAYBEACON A1, 1955 RED BEACON 1933 SOUND 1933 WHARF 1933

### T-12614

ED 1921

### T-12615

ARCH 1921 ARCHE CREEK BEACON 1933 BASE 1 (USE) 1931 BEAUFORT RIVER LIGHT 17, 1955 BEAUFORT RIVER LIGHT 13A, 1955 BUG 1933 BROOKLYN 1859 CHOW 1933 FORT FREMONT OBSERVATION TOWER 1931 DOS 1931 FORT FREMONT BEACON 1931 NORTH 1931 PARRIS ISLAND WATER TANK (WHITE WITH BLACK TOP)1932 PARRIS ISLAND, LOW WHITE STACK 1932 PARRIS ISLAND SILVER WATER TANK 1932 PARRIS ISLAND MARINE CORPS RECRUIT DEPOT AIR STRIP BEAGON 1955 PARRIS ISLAND HIGH BRICK STACK 1932 PARRIS ISLAND STACK (HIGHEST OF TWINS) 1932

PARRIS ISLAND MARINE CORPS, RECRUIT DEPOT, AIR CONTROL TOWER 1955
PARRIS (USE) 1931
PORT ROYAL SOUND LIGHT NO 1, 1955
SKULL CREEK DAYBEACON 4, 1955
SKULL CREEK ENTRANCE LIGHT 3, 1955
SKULL CREEK DAYBEACON 5, 1955
SPIT 1933
TRIANGULAR BEACON 1931

### T-12616

BULL 1933 MID 1931 TIDE 1933

### T-12617

STORY RIVER DAYBEACON A16, 1955 TEMPORARY 1955

### T-12618

BACK 1931
BULLPOINT FRONT RANGE 1931
BUCK 2, 1931
FRON 1931
MAG 1931
MARSH 2, 1931
MARTIN 1933
NO 9 (USE) 1931
OCHO 1921
SIETE 1931
SOUTH 1931
UIMER 1933

### T-12619

HILTON FRONT 1931 STONEY PLANTATION, BAPTIST CHURCH 1931 TON 1931 TON 2, 1955 WAL 3, 1955

### T-12620

BARNWELL PLACE LIGHT (OGLETHORPE REAR RANGE LIGHT) 1913
BLOODY 1932
BUSH (USE) 1932
ELBA ISLAND FLATS, LIGHT NO 11, 1932
FIELDS CUT NO 1 (USE) 1932
LOWER FLATS REAR RANGE LIGHT 1932
LAZAGETTO CREEK HIGHWAY BRIDGE CENTER OF SWING SPAN 1932
LONG ISLAND CROSSING FRONT RANGE LIGHT 1933

LONG ISLAND CROSSING REAR RANGE LIGHT 1933 NEW CHANNEL REAR RANGE LIGHT 1932 NORTH CORNER OF OLD TOWER 1932 PERRY (USE) 1934 PALMETTO 1933 QUARANTINE TANK FINIAL 1932 QUARANTINE (USE) 1932 TOPO 1934 TYBEE KNOLL CUT FRONT RANGE LIGHT 1932 UPPER FLATS FRONT RANGE TARGET 1932 UPPER FLATS REAR RANGE LIGHT 1932 WALLS CUT BEACON NO 6, 1932 WALLS CUT BEACON NO 8, 1932 WILMINGTON 1857 WILMINGTON ISIAND BLACK VENTILATOR, OGIETHORPE HOTEL 1933 WRIGHT 1932

### T-12621

BRAD 1931 DO 1916 FORT SCREVEN WATER TANK 1932 SAVANNAH BEACH, CASINO SOUTH COPOLA 1913 SAVANNAH BEACH, CASINO NORTH COPOLA, 1913 TYBRISA TANK 1932

### 4. VERTICAL CONTROL

A search was made for all tidal bench marks within the limits of these maps. Form 685A was submitted for each mark. One mark in each group was identified on the photograph, except in a few cases where there was no coverage.

### 5. CONTOURS AND DRAINAGE

Contours are inapplicable.

Drainage is almost entirely composed of tidal streams. Normal drainage is generally by direct run-off into marsh, swamp or the tidal streams.

### 6. WOODLAND COVER

Woodland Cover was classified in accordance with the Topographic Manual.

### 7. SHORELINE AND ALONGSHORE FEATURES

The high-water line has been indicated on the photographs by symbol in accordance with current instructions. No attempt was made to delineate the low-water line.

The field inspector accomplished this phase by several methods; Measurements from identifiable points of detail, by visual inspection from skiff, and by walking the shoreline.

All other shoreline features are adequately covered by field inspection notes on the photographs. The photography is recent, therefore, there have been no great changes.

### 8. OFFSHORE FEATURES

Several piling etc. were located either by sextant fix or theodolite cuts during this survey.

The obstruction reported at Lat. 32-01 - Long. 80-50 chart 1240, could not be seen at low-water.

Your attention is invited to the restricted area in Broad River, near Archers Creek. It is believed that the restricted area should be enlarged on the charts since most of this portion of the river is under fire by the marine guns.

### 9. LANDWARKS AND AIDS

All Nautical Landmarks have been investigated in the field and are reported on form 567.

All fixed Aids to Navigation were investigated and are reported on form 567. Third-order positions were obtained for the following:

TYBEE KNOLL CUT RANGE REAR LIGHT, 1964
TYBEE RANGE FRONT LIGHT, 1964
JONES ISLAND RANGE FRONT LIGHT, 1964
PORT ROYAL ENTRANCE, CHANNEL FRONT RANGE LIGHT, 1964

Four private aids in the Calibogue Sound area are recommended for charting. The aids were located by several methods; Cuts from triangulation stations and photo points, by sextant fixes, or identified directly on the photograph.

### 10. BOUNDARIES, MONUMENTS AND LINES

There have been no boundary lines shown.

### 11. OTHER CONTROL

There were no topographic stations established.

### 12. OTHER INTERIOR FEATURES

All roads were classified in accordance with Photogrammetry Instructions number 56.

Field Inspection of buildings was done in accordance with Photogrammetry Instructions Number 54, revised September 22, 1961.

There were no bridge or cable clearances measured during this survey.

Marsh and Swamp limits have been shown on the photographs where coverage was available.

### 13. GEOGRAPHIC NAMES

" 🕕

The investigation of Geographic Names will be handled slightly different from that called for in Project Instructions. This change in procedure was recommended by Dr. A. J. Wraight, Chief, Geographic Names Branch.

A systematic and complete investigation of Geographic Names wasmade from Savannah River North and East to Latitude 32-15. The remainder of the project will be investigated for discrepancies and New Names only.

The change in procedure is due to the recent investigation of names in the project during the years 1955, 1956 and 1957.

The Geographic Names Reports will be submitted at a later date.

### 14. SPECIAL REPORTS AND SUPPLEMENTAL DATA

Transmitting letters for Horizontal Control Identification were mailed to Washington separately for Part 1 and Part 2 of the Project. Part 1 was mailed on 10 July 1964 and Part 2 on 7 July 1964.

Form 567 will be forwarded with this report.

17 July 1964 Submitted by:

Joseph K. Wilson

Chief, Photo Party 6420

### Aerotriangulation Report

Project No. 21420

Charleston, South Carolina to Savannah, Georgia

### 21. Area Covered

The bridging covers the Atlantic Coast Shoreline of an area between Charleston, South Carolina to Savannah, Georgia.

### 22. Method

Nine strips were bridged on the Zeiss C-5 and C-9 stereoplanigraphs to provide control for compilation of shoreline.

Strip No.	Photos
1 9 4 5 6 7 8	645 1206 - 1227 644 4269 - 4273 644 4276 - 4284 644 4306 - 4312 644 4296 - 4302 644 4290 - 4294 644 4314 - 4327 644 4332 - 4337
10	64W 4286 - 4290

Strip #2 consisting of photos 64S 1184 - 1203 was not bridged. However, tie points were dropped from Strip #1 to provide control for graphic compilation of the area.

All strips were 1:30,000 scale photography.

### 23. Adequacy of Control

Control positions were adequate for bridge adjustment. However, the northeast end of Strip #1 was run as a separate bridge due to difficulty in holding the control. Both segments had control station Hernan in common. The points between the two bridges were averaged.

Strip #7 was also interrupted due to a water gap and divisis into two bridges, #7 and #10.

Strip (7) was ended at control station Queen because Strikes Strikes (130) would not hold. This was probably the 20 for the cases in Courth.

All other points held within accuracy requirements.

All common pass points between the strips were averaged ...

### 24. Supplemental Data

A number of objects identified as landmarks were used as check control stations and held within accuracy requirements.

### 25. Photography

Photography was adequate as to coverage, overlap and definition.

### 26. Recommendations

Ratio prints of Strip #2, at a scale of 1:20,000, have been ordered and will be submitted separately.

Submitted by:

176 LF

Lawrence Fritz John T. Gerlash

Approved by:

John C Cerrow Ir


Aerotriangulation Report Project No. 21420 Charleston, S.C. to Savannah, Ga.


Amendment to Report of Nov. 1964

Strip 9-A, consisting of photos 64-W-4329 through 4332, was bridged using three triangulation stations as control. Station Proctor Use, 1932 (SS #1) was of very poor image quality and could not be held in the bridge. A secondary straight line adjustment was applied to the junction area of Strips 8 and 9. This junction is weak but within National Map Accuracy Standards.

Submitted by:

John D. Perrow, Jr.

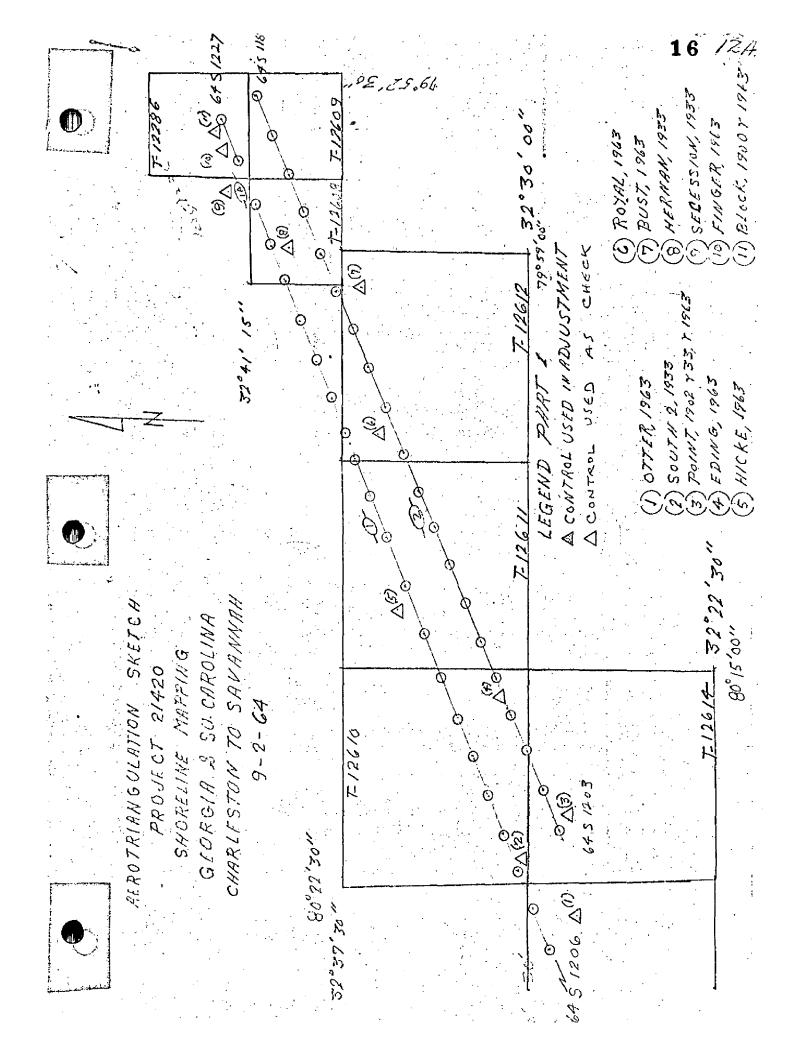

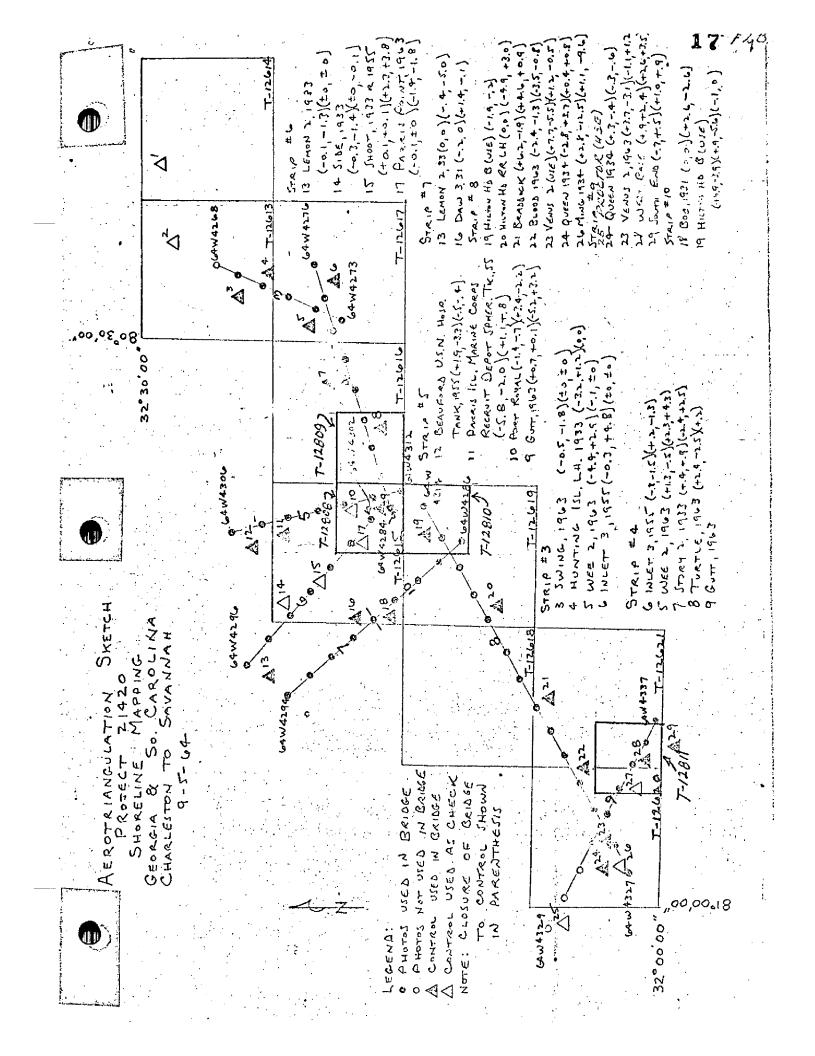



MAP T. 12811

Photogrammetry

SCALE FACTOR

FACTOR DISTANCE FROM GRID OR PROJECTION LIN IN METERS (BACK) FORWARD DISTANCE FROM GRID OR PROJECTION LINE IN METERS (BACK) N.A. 1927 - DATUM FORWARD CORRECTION DATUM PROJECT NO. 21420 (PH-6407)SCALE OF MAP 1:10,000 OR PROJECTION LINE IN METERS DISTANCE FROM GRID IN FEET. (BACK) FORWARD LONGITUDE OR x-COORDINATE LATITUDE OR V-COORDINATE 7 7 32° 021 39.67311 80 51 19.67311 32° 01' 38.953" 80 53 27.518 30.546" 10,167 17.597 23.085 68,686.68 2,047,788,72 2,037,144.54 70,423.72 2,033,827.30 2,032,572.99 2,042,189.36 75,933.25 2,045,571.36 75,013.12 68,835.93 67,591,27 32° 021 80 149 80 50 Ö DATUM 709 CONTROL FOR BRIDGING DATA p.11 ISLAND RANGEFIELD FORM PHOTOSTA TS PHOTOSTAT #18 BLOODY POINT RANGE PHOFOSTAT Desc 203 FC p. 19 PCs p.19 SOURCE OF PC p.19 GP p.40 CPs P. PCs -S P-46 (INDEX) #13 = BLOODY POINT RANGE FRONT LIGHT 1964 RANGE REAR LIGHT TYBEE LIGHTHOUSE FRONT LIGHT 1964 QUARANTINE (USE COCKSPUR LIGHT-REAR LIGHT 1964 WEST BASE (USE) FLAGPOLE 1964 JONES ISLAND FORT PULASKI FORT PULASKI STATION HOUSE 1902 1932 1963 JONES

DATE. BLB 1 FT. = .3048006 METER COMPUTED BY:...

2-3-65

CHECKED BY...

50 31.628 /

320, 8

=

SAVANNAH BEACH, MUNICIPAL WATERTAN

BHB

DATE 2-3-65

18

M - 2388 - 12

### COMPILATION REPORT

### T-12811

### 31. DELINEATION

The Wild B-8 was used. Field inspection was adequate. Photography was satisfactory.

### 32. CONTROL

See Aerotriangulation Report dated November 1964.

### 33. SUPPLEMENTAL DATA

None

### 34. CONTOURS AND DRAINAGE

Inapplicable

### 35. SHORELINE AND ALONGSHORE DETAILS

The shoreline inspection was adequate and was delineated accordingly.

### 36. OFFSHORE DETAILS

None

### 37. LANDMARKS AND AIDS

Form 567 for Landmarks and Aids have been submitted under date April 28, 1966.

### 38. CONTROL FOR FUTURE SURVEYS

None

### 39. JUNCTIONS

Junctions have been made with T-12620, scale 1:20,000, to the west and T-12621, scale 1:20,000 to the north and east. There is no contemporary survey to the south.

### 40. HORIZONTAL AND VERTICAL ACCURACY

No statement

### 46. COMPARISON WITH EXISTING MAPS

Comparison has been made with U.S.G.S. Quadrangle FORT PULASKI, S. C. - GA., scale 1:24,000, dated 1955, and A.M.S. Quadrangle SAVANNAH BEACH NORTH, GA. - S. C., scale 1:25,000, dated 1955.

### 47. COMPARISON WITH NAUTICAL CHARTS

Comparison has been made with Chart 1240, scale 1:80,000, 6th edition, dated April 20, 1964; Chart 1241, scale 1:80,000, dated November 27, 1961; and Chart 440, scale 1:40,000, 30th edition, Dated December 7, 1964.

### ITEMS TO BE APPLIED TO NAUTICAL CHARTS IMMEDIATELY

None

### ITEMS TO BE CARRIED FORWARD

None

Submitted:

R. J. Pate

Cartographic Tech.

Approved:

Allen L. Powell, RADM, NOAA

Director, Atlantic Marine Center

GEOGRAPHIC NAMES FINAL NAME SHEET PH-6407 (South Carolina) T-12811

Atlantic Ocean Chimney Creek Cockspur Island Crab Creek Estill Hammock Fort Pulaskie Fort Screven Horse Pen Creek Horse Pen Hammock Lazaretto Creek Oyster Bed Island

\* Savannah Beach (beach) Savannah Beach (town) Savannah River Sazarine Creek South Channel Spring Island Tybee Island Tybee Knoll Cut Range Tybee Knoll Spit Tybee Range Tybee Roads

Approved by:

A. Joseph Wraight Chief Geographer

Prepared by:

Frank W. Pickett Cartographic Technician

\* Name not applied to map, since town name is the same.

CITIS.

49. NOTES FOR THE HYDROGRAPHER

None.



C&GS FORM 1002			· u.	S. DEPARTMENT OF COMMERCE
	PHO		RIC OFFICE REVIEW	
	•	T-1	10363 T-12811	•
1. PROJECTION AND GRIDS	2 TITLE	·	3. MANUSCRIPT NUMBERS	4. MANUSCRIPT SIZE
R <b>JP</b>	RJP		RJP	RJP
CONTROL STATIONS	<u> </u>			<u> </u>
S HORIZONTAL CONTROL ST	ATIONS OF	6. RECOVERA	PLE HORIZONTAL STATIONS	7. PHOTO HYDRO STATIONS
RJP	CCORAL Y	(Topographic	s etations)yy	xx
BENCH MARKS	9. PLOTTING C	F SEXTANT	10. PHOTOGRAMMETRIC	11. DETAIL POINTS
XX	X	X	BRIDGE (WO)	KELSH
ALONGSHORE AREAS (Nautice	Chart Data)			
12. SHORELINE	13. LOW-WATER	RLINE	14. ROCKS, SHOALS, ETC.	15. BRIDGES
RJP	RJP		RJP	XX :
16. AIDS TO NAVIGATION	17. LANDMARK	(S	18. OTHER ALONGSHORE PHYSICAL FEATURES	19. OTHER ALONGSHORE CULTURAL FEATURES
· RJP	RJP		RJP	RJP /
PHYSICAL FEATURES				
20. WATER FEATURES		21. NATURAL	GROUND COVER	22. PLANETABLE CONTOUR
RJP			RJP .	XX
23. STEREOSCOPIC INSTRUMENT CONTOURS	24. CONTOURS		25. SPOT ELEVATIONS	26. OTHER PHYSICAL FEATURES
XX	•	XX	XX	RJP
CULTURAL FEATURES	-			
27. ROADS	28. BUILDINGS	5	29. RAILROADS	30. OTHER CULTURAL FEATURES
R <b>JP</b>		RJP	××	XX
BOUNDARIES 31. BOUNDARY LINES			32. PUBLIC LAND LINES	
XX	٠		XX	
MISCELLANEOUS				
RJP		34. JUNCTION	s RJP	35. LEGIBILITY OF THE MANUSCRIPT RJP
36. DISCREPANCY OVERLAY	37. DESCRIPT	IVE REPORT	38. FIELD INSPECTION PHOTOGRAPHS	39. FORMS
XX	RJP		RJP	RJP
40. REVIEWER			SUPERVISOR, REVIEW SECTI	ON OR UNIT
RJP			ACR	
41. REMARKS (See attached she	et) ·			
FIELD COMPLETION ADDITIO		TIONS TO THE	MANUSCRIP T	
42. Additions and correction script is now complete ex	s furnished by the	he field completed the field completed the field complete the distribution of the field complete the field c	tion survey have been applied	to the manuscript. The manu-
COMPILER			SUPERVISOR	
			<b>!</b>	
43. REMARKS	<u> </u>		<u> </u>	
•			•	
•			•	•
<b>'</b>			1	•
•				



## U.S. DEPARTMENT OF COMMERCE COAST AND GEODETIC SURVEY

NONFLOATING AIDS ORDICANDMARKSCHORGHARDS

STRIKE OUT TWO TOUBELDEKETED TO BE CHARTED TOTOEREVISED

C&GS FORM 567

ATLANTIC MARINE CENTER

19.65

I recommend that the following objects which have (have show) been inspected from seaward to determine their value as landmarks be charted on (deteted stroin) the charts indicated.

C. Bishop

The positions given have been checked after listing by

				•		J.Bul	J. Bull, Director.	tor, AMC	D)	Š	Gilof of Party	Party
174.	ATEGORE ANTIONAL HEINS		,	4	POSITION			METHOD			THAND	
	COULT CANCELINA - CECNOTA		ž	LATITUDE	LONG	LONGITUDE: +		LOCATION		OH CH		CHARTS
CHARTING	DESCRIPTION	BIGNAL	•	D.M.METERS	•	" D.P. METERS	DATUM	BURVEY No.	verified	HARE	E410	
	SAVANTAH RIVER											
	TYBEE RANGE FRONT LIGHT 1964 L.L. No. 4547	-	32 00	12.218 382.5	8D 48	17.256 1.52.9	M 1927	T-12621	6-5-64	×		1240
			1									
	(TYBEE LIGHTHOUSE 1932)		32 01	19.301	80 50	111.985 1180.5	E	T=15867	79-1-9	×		1210
	L. L. No. 4324, 4548											
,	BLOODY POINT RANGE FRONT LIGHT		32 02	30.533 91.0.1	80 149	1062.9	#-/	tl	19-1-9	×		1240
,	BLOODY POINT RANGE REAR LIGHT 1964 L.L. No. 4554		32 03	17.590	80 50	23, 135	E	п	6-4-64	×		121,0
					٠.							
,	JONES ISLAND RANGE FRONT LIGHT		32 02	30.95 <u>1.</u> 953.1.	80 51	10.695	u	#	79-5-9	×	14. h.	1240 1240
						i					,	
7	JONES ISLAND RANGE REAR LIGHT		32 02	39.669 1221.8	80 51	10.736 1068.7	<b>E</b> .	E	79-77-9	: × ×		1200
ţ						ì						ı
·					'							

USCOMMEDC 16234-P61 This form shall be prepared in accordance with Hydrographic Manual, Publication 20.2, Sec. 1-55, 2-39, 6-36, 7-18 to 22 inclusive, and Fig. 79. Positions of charted The data should be landmarks and non lloating aids to navigation, if redetermined, shall be reported on this form. Revisions shall show both the old and new positions. considered for the charts of the area and not by individual field survey sheets. Information under each column heading should be given. \* TABULATE SECONDS AND METERS

U.S. DEPARTMENT OF COMMERCE COAST AND GETTIC SURVEY

# NONFLOATING AIDS ORMEANDMARKS FOR CHARTS

STRIKE OUT TWO. TO BE CHARTED TO BEDELETER **COSEREVISED** 

C&GS FORM

A'TLANTIC MARINE CENTER

June 17

99 61

I recommend that the following objects which have (haraconat) been inspected from seaward to determine their value as landmarks be

charted on (detectatyfrom) the charts indicated.

Chiacost Parox J. Bull, Director B.Wilson The positions given have been checked after listing by

					POSITION			CORE		THA	THAN	•
STATE G	GEORGIA - SOUTH CAROLINA		5	LATTITUDE #	LONG	LONGITUDE +	ì	LOCATION	DATE	08 CH	CHARTS	
CHARTHO	DESCRIPTION	BIGNAL	•	O M SEYEDE	•	D. P. METERS	DATUM	BURVEY No.	מפועס	HSM1 LETM	1410	ĺ
NAME	CONTRACT OF CASE AND ADDRESS OF THE PARTY OF											
	SAVANNAH KIVER		- 1	7,7	,	23		TOT	(Y-X-Y)	>	0/1	1
TIGHT	(TYREE KNOLL CUT RANCE REAR		32 01	1735	파스 CB	7	1927	t-12620				. 1
Light	Tybee Knoll Cut Range Front		32 01	59.20	80 53	55.06	<b>±</b> ,	Photo T-12620	19-1-9	×	0111	-
LIGHT	Light New Channel Range Front Light		32 02	20.65	80 55	112.19	E	Ph 12820	E	×	01/1	. 1
LIGHT	New Channel Range Rear Light		32 02	25.97	80 56	18.60	=	= , =	H	×	o <del>rr</del> .	
LIGHT	Lower Flats Range Front Light		32 04	15.10	80 57	18.61.	E	==	tl9-6-9	×	017	
31.	Lower Flats Range Rear Light		32 04	13.60	80.57	08.35	E	# F	=	×	OTT	1
LIGHT	Oglethorpe Range Rear Light		32 05	5633	80 59	50.16	×	2.5	1/9-17-9	×	077	
	SAVANNAH RIVER											[
LIGHE	Elba Island Training Wall	·	32 05	31.30	80 59	25.09 658	£.	E 55	=	×	O <sup>17</sup> 1	_ }
LIGHT	Elba		32 04	22.92	80 58	30,81	н	= =	79-6-9	×	O <sup>1</sup> 1	_
LIGHT	Elba Island Light 39		32 04	33.70	80 58	56.09 11.71	£	E E	=	×	277	_
	SAVANNAH RIVER							1				
LIGHT	2 Lazaretto Creek Light 2		32 01	08,18	80 52	12563	=	r=12829	†G-†-o	×	1200	
												•

The data should be This form shall be prepared in accordance with Hydrographic Manual, Publication 20.2, Sec. 1-55, 2-39, 6-36, 7-18 to 22 inclusive, and Fig. 79. Positions of charted landmarks and nonfloating aids to navigation, if redetermined, shall be reported on this form. Revisions shall show both the old and new positions. considered for the charts of the area and not by individual field survey sheets. Information under each column heading should be given. # TABULATE SECONDS AND METERS

T-128//

4 [ 206 ] 176,5 41809,0 202.2 4/1038 4/147/30 367.8 161.1

4 15 94 25 4 1940.4 4 17062.4 4 151.7 4 1280.6 4 1953:4 104.8 4141930 4521930 41729.0 417323.0

### U.S. DEPARTMENT OF COMMERCE TIC SURVEY COAST AND GEG

MONETONETING ALDS OR LANDMARKS FOR CHARTS TO BE CHARTED MOGBEREVISED

ATLANTIC MARINE CENTER

June 17

I recommend that the following objects which have (have come) been inspected from seaward to determine their value as landmarks be STRIKE OUT TWO

The positions given have been checked after listing by charted on (deleted stromt, the charts indicated.

JOURE DEVELOE DE

B. Wilson

.Bull,Director

					POSITION			МЕТНОВ	ļ.	THAN		
STATE G	GEORGIA - SCUTH CAROLINA		5	ATTITODE *	LONGE	LONGITUDE		LOCATION	LOCATION	110H	I S	CHANTS
CHARTING	DESCRIPTION	BIGNAL	•	D.M.METERS	-	D. P. METERS		Š		SMI	440	
H K C Z	SAVANNAH RIVER				_ = <del> </del>						_	
		·			•			<del></del> .				
NOLD TOWER			32_01	20.915	80 52	1,18,601	NA 192	7 TRI F-12620	verified x 4-29-64	×	77	11.0 1.21.0
aband LT HO	(0) black, bettem white, nt#190467 tt. (cocksrur Lighthouse 1902)							r-12611				
								ť.				
TANK	4-legged steel structure painted		32 00	16.057	80 59	52.364	=	TRI. r-12620	==	×	-	1240
	(OGLETHORPE HOTEL, WATER TANK						<i>;</i>					
	1356/						,	<u> </u>				
Cio.	3-legged steel abandoned range		ηo 2ε	33.90	80 58	56.93	=	PHOTO T-12620	19/6/7	×		0770
					/ .		,				$\dashv$	
_						/		-			-	
												-
S. S. O. O. S.	This is the same LDWK reported with	th T-12811	11 with	with different	بر							
	int	tion							1 Eig 79	Positi	9 800	Doctrions of charted

USCOMMEDC 16284-P81. This form shall be prepared in accordance with Hydrographic Manual, Publication 20.2, Sec. 1-55, 2-39, 6-36, 7-18 to 22 inclusive, and Fig. 79. Positions of charted landmarks and nonfloeting side to navigation, if redetermined, shall be reported on this form. Revisions shall show both the old and new positions. considered for the charts of the area and not by individual field survey sheets. Information under each column heading should be given.

\* TABULATE SECONDS .. AND METERS

C&GS FORM FAT

### U.S. DEPARTMENT OF COMMERCE COAST AND GT DETIC SURVEY

## NONETOWITINGXMIDSXORXLANDMARKS FOR CHARTS

STRIKE OUT TWO TO BE CHARTED TO BE TO BE REVISED X TO SECUENE YEB

ATLANTIC MARINE CENTER

Dec. 30 , 19 65

I recommend that the following objects which have (have that) been inspected from seaward to determine their value as landmarks be

C. Bishop

The positions given have been checked after listing by charted on (deletedrifrom) the charts indicated.

XChiefof Partx J.Bull, Director, AMC

CHARTS 1240 1240 OFFSHORE CHART THEHORE CHART HARBOR CHART × 1-29-67 rerified T-12811 4-29-64 LOCATION LOCATION AND SURVEY No. 4 NA 1927 DATUM 14.985 31.690 D. P. METERS 1180. LONGITUDE. 50 公 POSITION 80 . 80 19.301 39.717 D.M. METERS 223,3 591.5 LATITUDE\* . . 8 5 32 32 BIGNAL 12811 ower part black, vr. 150 (155)ft SAVANNAH BEACH, MUNICIPAL WATER TANK, 1964 (Elév. steel HT.158 (Octaronal brick tower, upper part black, middle part white, 00 SOUTH CAROLINA - GEORGIA mapped TYBEE LIGHTHOUSE 1932 DESCRIPTION Objects CHARTING STATE TYBEE TANK

USCOMM-DC 16284-P61 This form shall be prepared in accordance with Hydrographic Manual, Publication 20.2, Sec. 1-55, 2-39, 6-36, 7-18 to 22 inclusive, and Fig. 79. Positions of charted landmarks and nonflosting side to navigation, if redetermined, shall be reported on this form. Revisions shall show both the old and new positions. The data should be considered for the charts of the area and not by individual field survey sheets. Information under each column heading should be given. # TABULATE SECONDS AND METERS

6

### REVIEW REPORT T-12811

### SHOREL INE

July 15, 1971

### 61. GENERAL STATEMENT:

See Summary on page 6 of this Descriptive Report.

An ozalid comparison print, pages 30 through 36, with differences noted in Items 62 through 65, is bound with the original of this report.

### 62. COMPARISON WITH REGISTERED TOPOGRAPHIC SURVEYS:

A comparison was made with T-6154 b, scale 1:10,000, dated July-August 1934. This was a control survey and only short stretches of shoreline were mapped. Differences between the old survey and T-12811 are shown in blue on the comparison print.

The north tip of Tybee Island apparently has eroded about 400 meters.

T-12811 supersedes T-6154 b for charting purposes and will be superseded by TP-00277, Project PH-7101, when it is completed.

### 63. COMPARISON WITH MAPS OF OTHER AGENCIES:

A comparison was made with U.S.G.S. Quadrangle FORT PULASKI, S. C. - GA., scale 1:24,000, dated 1955, and with A.M.S. Sheet SAVANNAH BEACH NORTH, GA., S.C., scale 1:25,000, dated 1957. Differences between these maps and T-12811 are shown in brown on the comparison print.

The shoreline in Chimney Creek and Horse Pen Creek does not have the same alignment and there is noticeable difference in shoreline placement at the east end of Oyster Bed Island. There is no noticeable difference in shoreline on the east side of Tybee Island.

A wreck, not visible on the photographs, is shown at latitude 32<sup>0</sup>00.8', longitude 80<sup>0</sup>49.6'.

### 64. COMPARISON WITH CONTEMPORARY HYDROGRAPHIC SURVEYS:

The most recent survey available for comparison was a copy of the verified smooth sheet for H-5592, scale 1:10,000, dated June-July-December 1934. The larger differences between this survey and T-12811 are shown in purple on the comparison print.

The extent of Oyster Bed Island has increased and the north tip of Tybee Island has eroded since H-5592 was compiled.

### COMPARISON WITH NAUTICAL CHARTS:

A visual comparison was made with Chart 440, scale 1:40,000, 35th edition, dated July 25, 1970. Differences between this chart and T-12811 are shown in red on the comparison print.

A wreck is charted at lat.  $32^{\circ}01.4^{\circ}$ , long.  $80^{\circ}50.2^{\circ}$ . It also is shown on H-5592 and SAVANNAH BEACH. No object is visible at this position on the photographs.

A reported obstruction is charted at lat. 32000.81, long. 80049.61. No image is visible on the photographs at this point.

A pier or groin, not visible on the photographs, is charted at lat. 32<sup>o</sup>01.3', long. 80<sup>o</sup>51.7'.

### 66. ADEQUACY OF RESULTS AND FUTURE SURVEYS:

This survey complies with Project Instructions, Bureau requirements, and the National Standards for Map Accuracy. No accuracy tests were run in the field.

Reviewed by:

Charles H. Bishop

Charles H.Bishop

Cartographer

July 15, 1971

Approved for forwarding:


Welvin J. Umbach, CDR, NOAA
Chief, Photogrammetry Division, AMC


Approved:


Allen L. Powell, RADM, NOAA
Director, Atlantic Marine Center


Approyed:


Chief, Photogrammetric Branch Chief, Photogrammetry Division

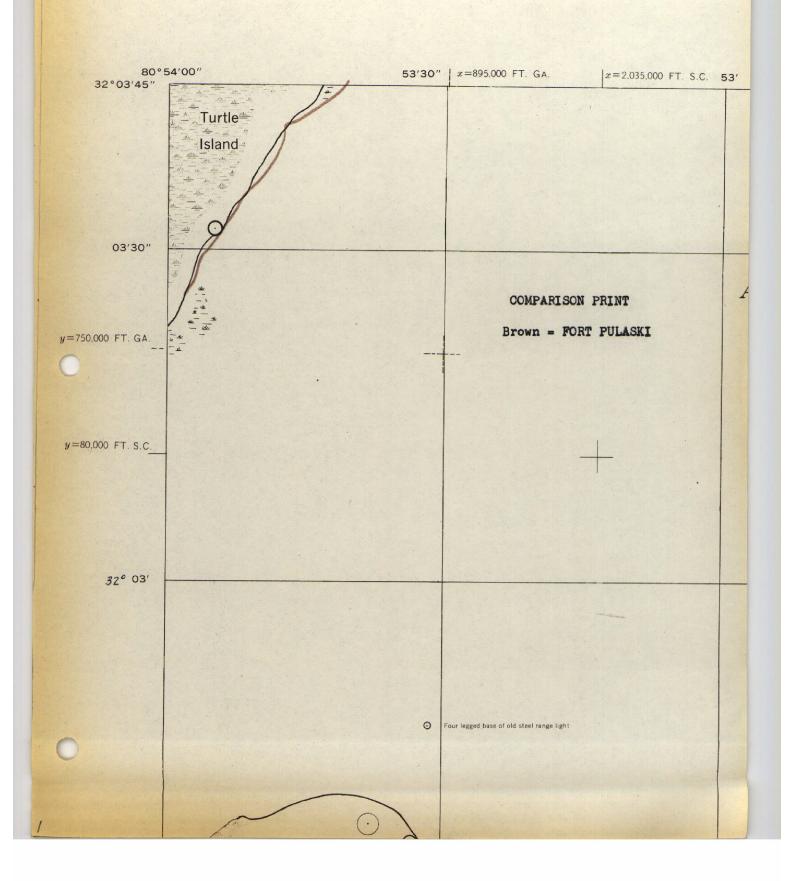


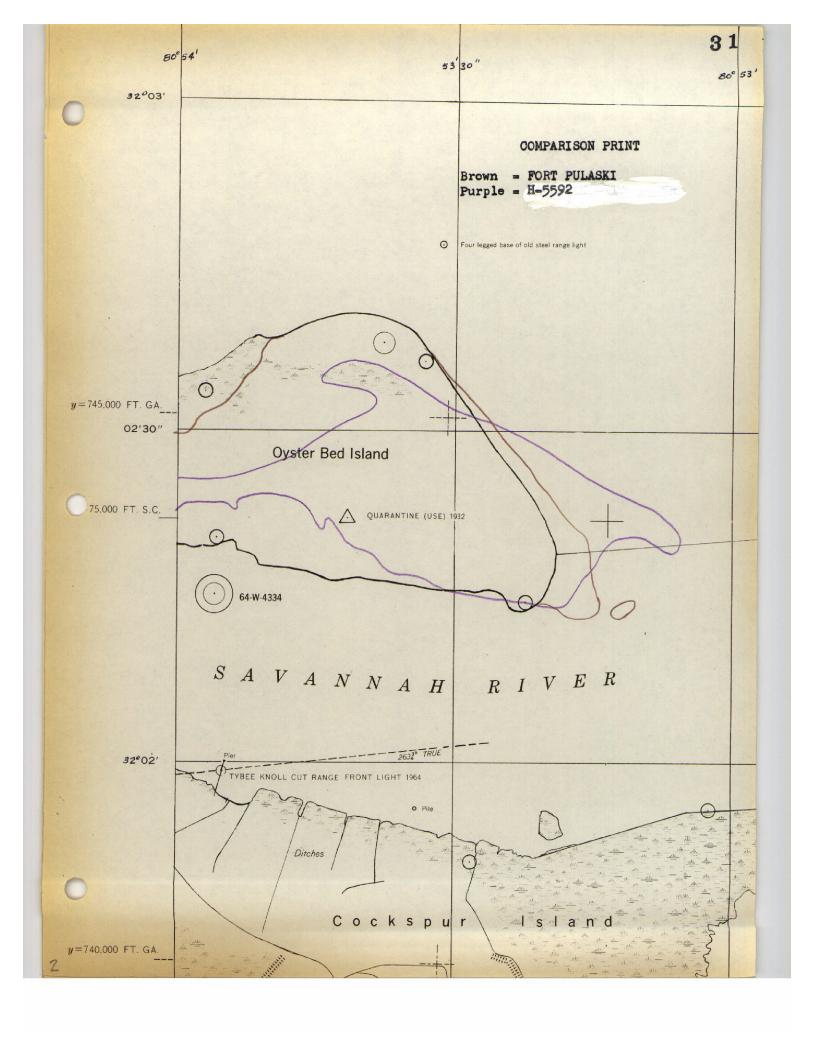


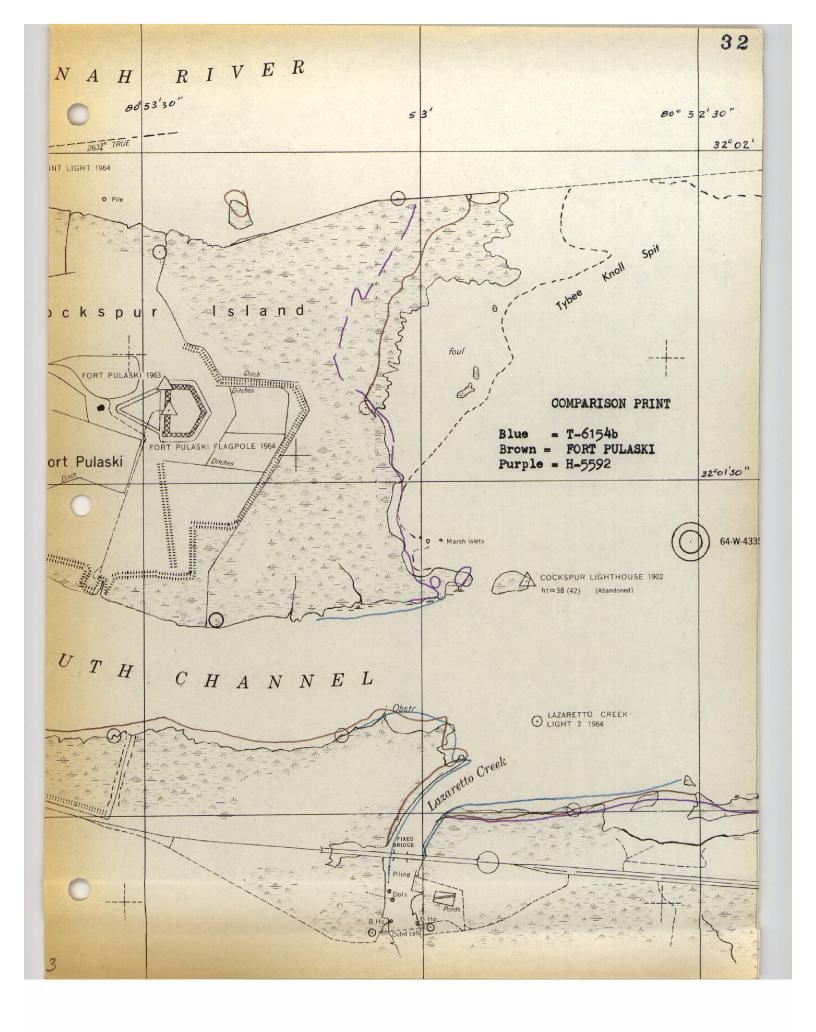

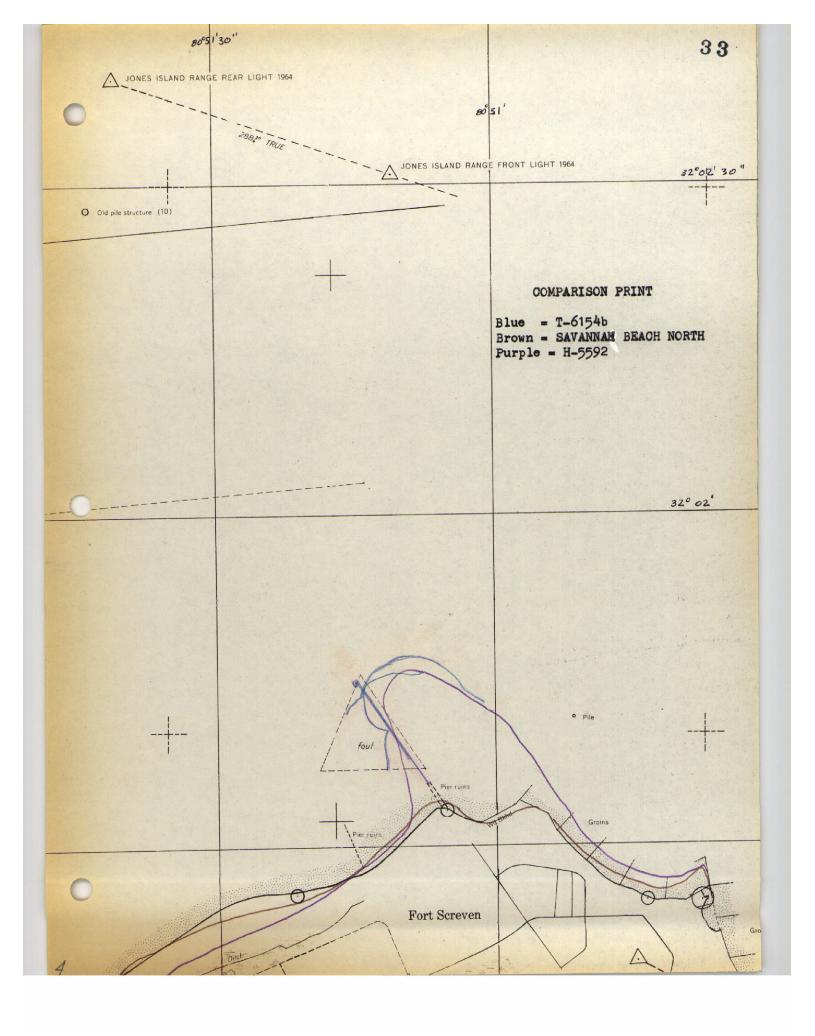

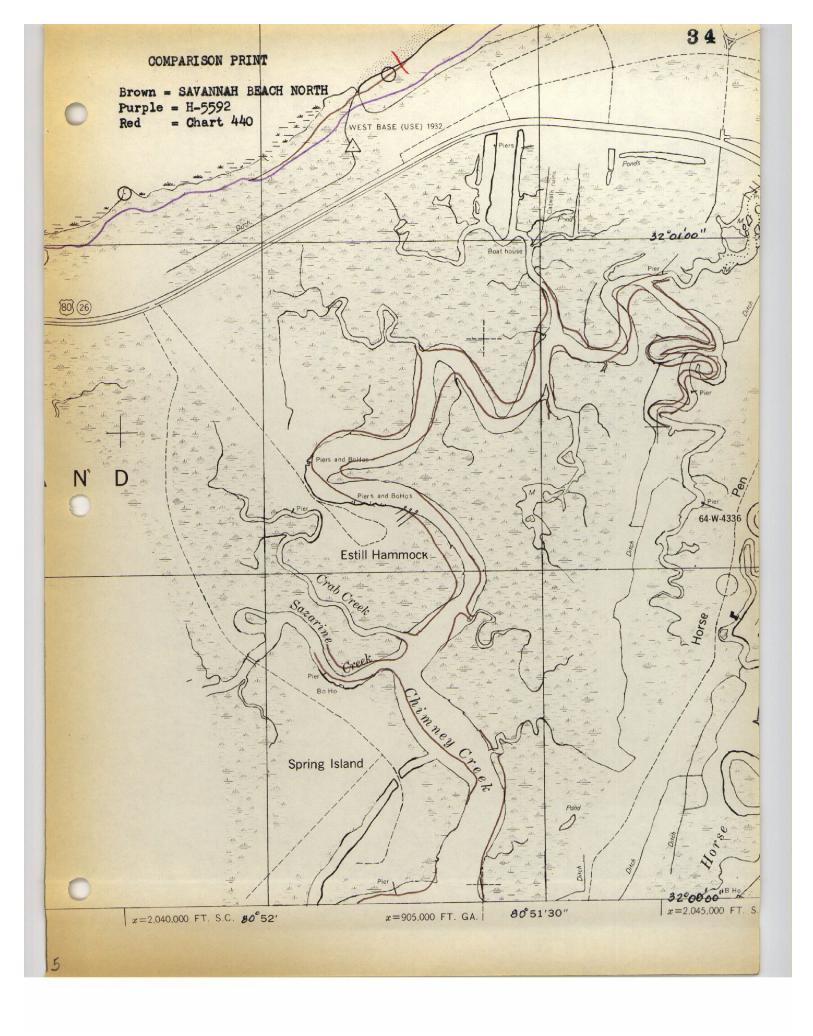

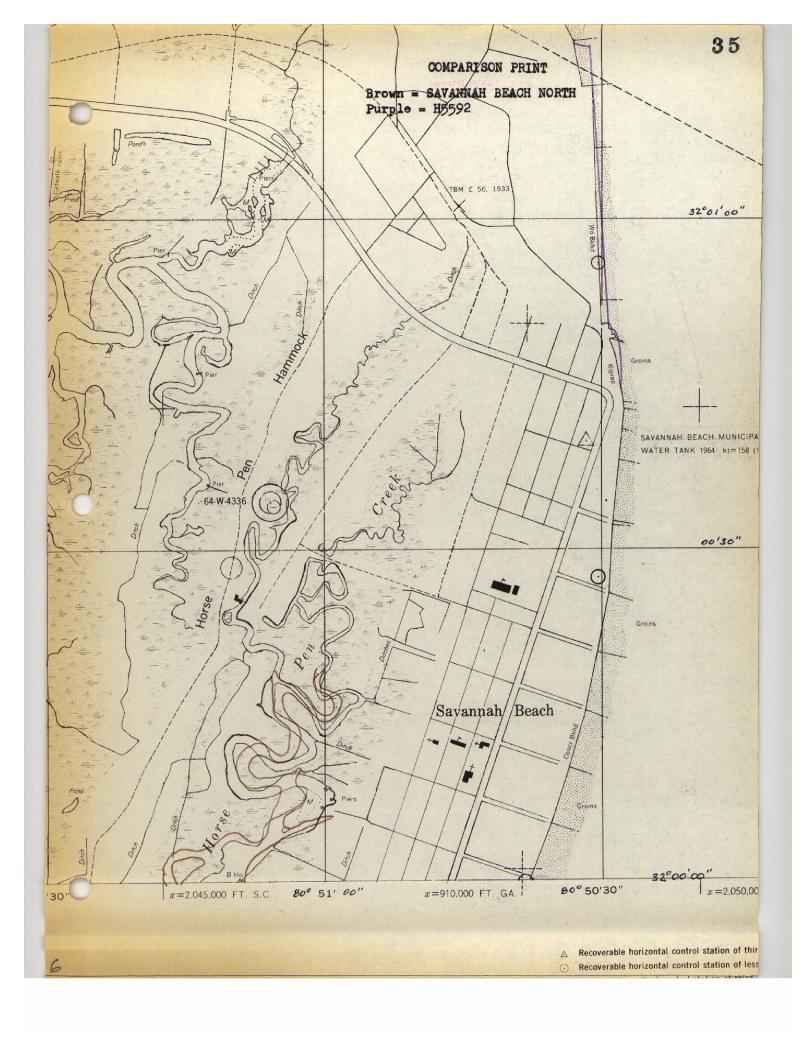

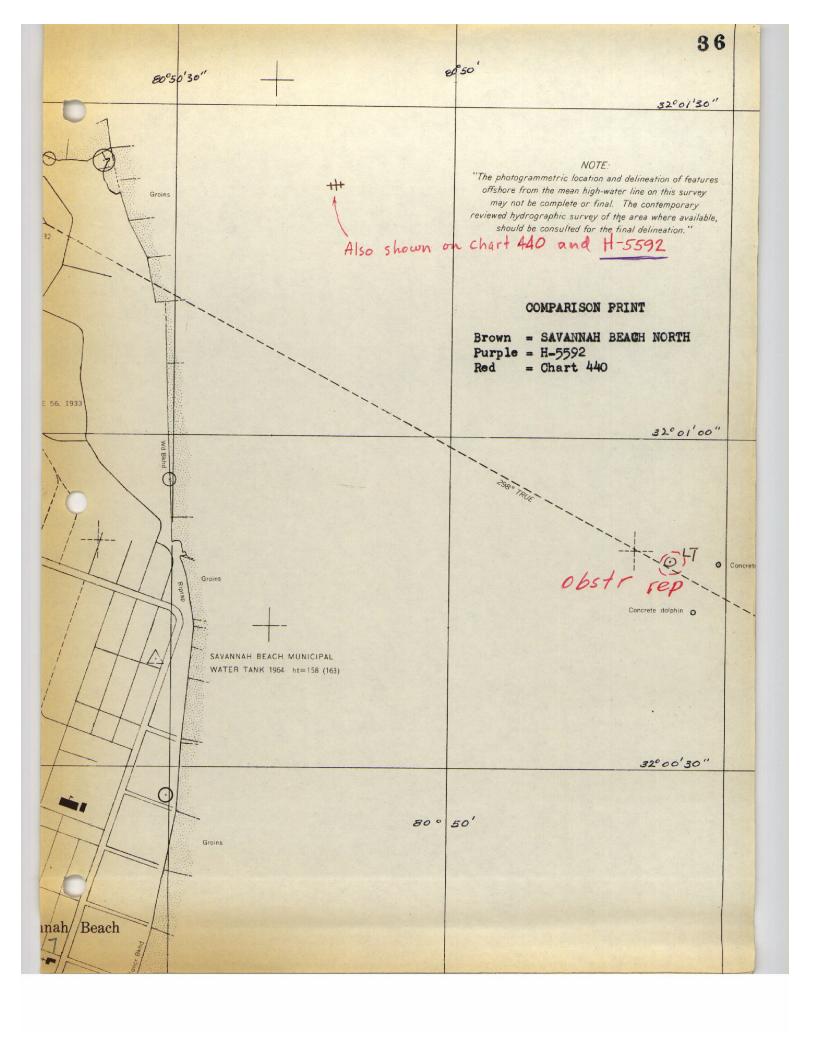

### NAUTICAL CHART DIVISION

### RECORD OF APPLICATION TO CHARTS

T-12811 FILE WITH DESCRIPTIVE REPORT OF SURVEY NO. \_\_

### INSTRUCTIONS

A basic hydrographic or topographic survey supersedes all information of like nature on the uncorrected chart.

1. Letter all information.

2. In "Remarks" column cross out words that do not apply.

3. Give reasons for deviations, if any, from recommendations made under "Comparison with Charts" in the Review.

CHART	DATE	CARTOGRAPHER	REMARKS
241	1-13-72	C.E. Harrington	Full Pert Before After Verification Review Inspection Signed Via
		4	Drawing No. NO CORE- SMALL SCALE & IN AREA OF
4			OMITTED DETAIL - WILL BE SUPERSEDED BY TP- 00277
440	4-26-72	Ratilli	Full Part Before After Verification Review Inspection Signed Via
	7 20 70	<u> </u>	Drawing No. 3 4
-			
440	10-18-74	DIPothice	Full Part Before After Verification Review Inspection Signed Via
<del>-                                      </del>	14.14.15	UCI WILLIAM	Drawing No. 37
	<del></del>	<del></del>	
			Full Part Before After Verification Review Inspection Signed Via
	[		Drawing No.
	<b></b>		
<del></del>		<u> </u>	Full Part Before After Verification Review Inspection Signed Via
	<b></b>	i	Drawing No.
<del></del> -			,
	<u> </u>		Full Part Before After Verification Review Inspection Signed Via
	<u></u>		Drawing No.
	<u></u>	· · · · · · · · · · · · · · · · · · ·	Drawing No.
<u> </u>	<u> </u>	· · · · · · · · · · · · · · · · · · ·	Full Part Before After Verification Review Inspection Signed Via
		<u> </u>	
<del></del>		<u> </u>	Drawing No.
<del></del>			
			Full Part Before After Verification Review Inspection Signed Via
			Drawing No.
		·	
<del></del> _	 	r	Full Part Before After Verification Review Inspection Signed Via
			Drawing No.
<del></del>			
			Full Part Before After Verification Review Inspection Signed Via
			Drawing No.
	`.		
<del></del> -			
	<del> </del>	<u> </u>	<del> </del>