FORM C&G5-504

U.S. DEPARTMENT OF COMMERCE ENVIRONMENTAL SCIENCE SERVICES ADMINISTRATION COAST AND GEODETIC SURVEY

# DESCRIPTIVE REPORT

- <del>,- ,- ,- ,- ,- ,- ,- ,- ,- ,- ,- ,- ,- ,</del>
Type of Survey Shoreline (Photogrammetric
Field No. Office No. T-12290
LOCALITY
State North Carolina
General locality Long Bay
Locality Lockwoods Folly Inlet
1 <del>9_64=6</del> 5 1962-64
CHIEF OF PARTY J.K. Wilson, Chief of Field Party Allen L. Powell, Director, AMC
LIBRARY & ARCHIVES

DATE .....

USCOMM-DC 37022-P66

	DESCRIPTIVE REPO	ORT - DATA -12290	RECORD		
JECT NO. (II):					
PH-6217					
FIELD OFFICE (II);			CHIEF OF PARTY		
Myrtle Beach	n, South Carolin	na	Joseph	K. Wilso	מ
PHOTOGRAMMETRIC OFFICE (III):			OFFICER-IN-CHAP	₹GE	
Atlantic Mar	ine Center		Allen L.	Powell,	Director
INSTRUCTIONS DATED (III) (III):					
11 Septe	ember 1963 - Fie	eld			
14 Octob	oer 1963 - Off	ice			
10 Janus	ary 1964 - Off	ice, Am	endment I		
METHOD OF COMPILATION (III):					
	ec el 1 707 II				
MANUSCRIPT SCALE (III):	Kelsh Plotter	STEREOSCO	PIC PLOTTING INS	TRUMENT SCALE	E (III) :
MANAGERITY I SCREEN HILL					
1:20,00			000 Pantog		
DATE RECEIVED IN WASHINGTON OFF	ICE (IV);	DATE REPO	RIED TO RAGISCA	C CHART BRANC	en uvr:
APPLIED TO CHART NO.		DATE:		DATE REGISTE	RED (IV):
<u> </u>				! <u> </u>	
GEOGRAPHIC DATUM (III):			VERTICAL DATU		high water
			Elevations shown		
NA 1927	,		Elevations shown	as (5) refer to sou	nding datum
1122 12 / 5 ;		•	i.e., mean low wat	er or meen lower lo	ow water .
REFERENCE STATION (III):					
FC	LLY, 1934				
LAT.	LONG.:		X ADJUSTED		
33° 57' 01.139"	78° 13՝ 20.2կ	4"	UNADJUSTED		
PLANE COORDINATES (IV):			STATE	Z	ONE
73,831.16 ft.	×= 2,235,893.44	ft.	North Car	olipa	
OR (IV) WASHINGTON OF FICE.		<del></del>			RIC OFFICE,
WHEN ENTERING NAMES OF PERSONNE	EL ON THIS RECORD GIVE T	HE SURNAME	AND INITIALS, NOT	INITIALS ONLY.	

U.S. DEPARTMENT OF COMMERCE ENVIRONMENTAL SCIENCE SERVICES ADMINISTRATION COAST AND GEODETIC SURVEY

### DESCRIPTIVE REPORT - DATA RECORD

DESCRIPTIVE REPORT - DATA RECORD	
FIELD INSPECTION BY (II):	DATE:
R. S. Tibbetts and Erwest W. Hartford	FebApr. 1964
Mean high water compiled from field inspect photography of August 1962.	tion notes on
PROJECTION AND GRIDS RULED BY (IV):	DATE
A. E. Roundtree	Dec. 1963
PROJECTION AND GRIDS CHECKED BY (IV):	DATE
V. Silverman	Dec. 1963
CONTROL PLOTTED BY (III):	DATE
A. Santillan	Jan. 1965
CONTROL CHECKED BY (III):	DATE
H. Cordell	Jan. 1965
RADIAL PLOT OR STEREOSCOPIC CONTROL EXTENSION BY (III):	DATE
W. Heinbaugh	Nov. 1964
STEREOSCOPIC INSTRUMENT COMPILATION (III): PLANIMETRY	DATE
B. Wilson	Mar. 1965
CONTOURS	DATE
MANUSCRIPT DELINEATED BY (III):	DATE
B. Wilson	April 1965
SCRIBING BY (III):	DATE
PHOTOGRAMMETRIC OFFICE REVIEW BY (III):	DATE
R. E. Smith	May 1965
REMARKS:	<del></del>

FIELD EDIT - NONE

### **DESCRIPTIVE REPORT - DATA RECORD**


ERA (KIND OR SOURCE) (III):

	S Camera	TOGRAPHS (III)				
NUMBER	DATE	TIME	SCALE	s	TAGE OF TI	DE
62 <b>\$</b> 827 A	24 Aug 1962	0800	1:30,000	0.3	ft. abo	ve MLV
625906A-62 <b>5</b> 911A	29 Aug 1962	0834	1:30,000	3.4	ft. abo	ove MLV
		TIDE (III)		J		
				RATIO OF RANGES	MEAN RANGE	SPRING RANGE
REFERENCE STATION:	Charleston	, S.C.			5.2	6.1
SUBORDINATE STATION:	ockwoods Folly	y Inlet,	S.C		4.2	4.8
SUBORDINATE STATION:	· <del></del> -					
WASHINGTON OFFICE REVIEW BY	(iv): Leo F. Ber	ugnet		DATE:	ne 197:	 l
PROOF EDIT BY (IV):				DATE:		
NUMBER OF TRIANGULATION ST	ATIONS SEARCHED FOR (	<sup>11):</sup> 9	RECOVERED:	IDENTIF	ED:	
NUMBER OF BM(S) SEARCHED FO	R (II):	3	RECOVERED:	IDENTIF	O O	

NUMBER OF TEMPORARY PHOTO HYDRO STATIONS ESTABLISHED (III): DODE

REMARKS:

COMPILATION RECORD	COMPLETION DATE REMARKS
Manuscript complete pending edit	April 1965
Final Review	June 1971
-	

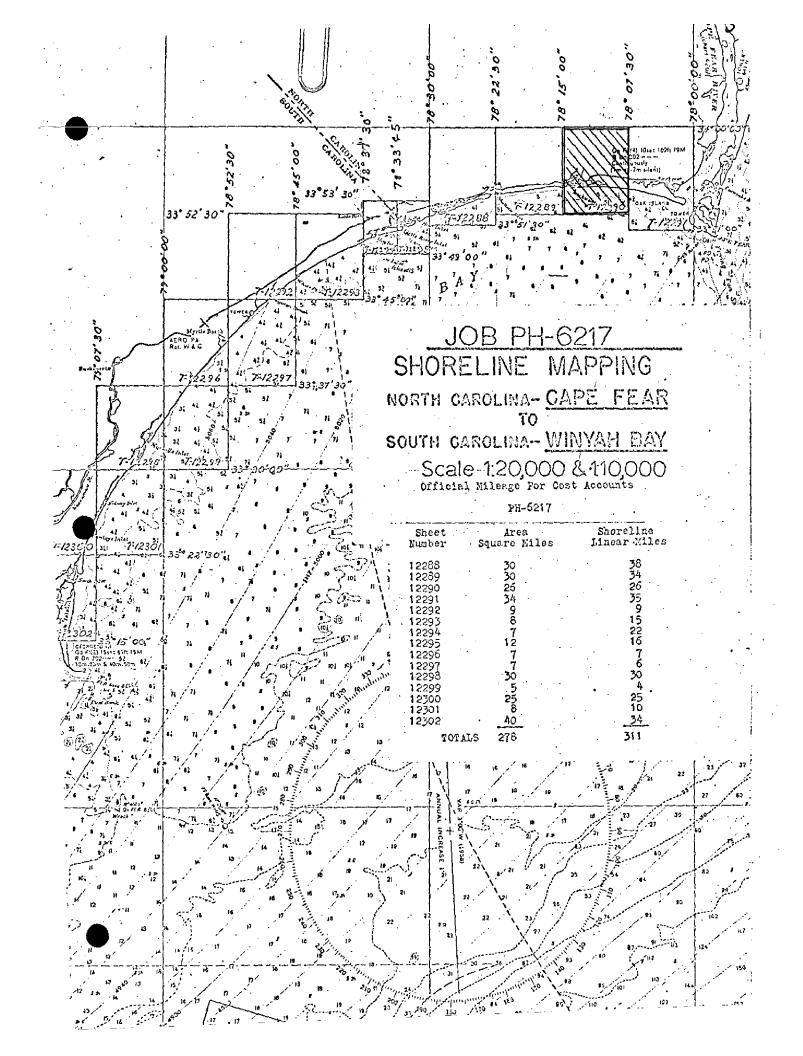

### SUMMARY TO ACCOMPANY

### DESCRIPTIVE REPORT T-12290

Shoreline survey T-12290 is one of fifteen similar surveys in project PH-6217. Thirteen surveys were compiled at 1:20,000 scale and two at 1:10,000 scale. This survey is in the vicinity of Long Beach and includes Lockwoods Folly Inlet and part of Lockwoods Folly River. See page 5 of the Descriptive Report for the location of the survey within the project.

Field work preceded compilation. This consisted of recovery and identification of horizontal control, shoreline and interior field inspection, location of fixed aids to navigation and selection of landmarks for charts.

The purpose of this survey was to provide new shoreline and photo-hydro support data for hydrographic surveys to be made in the area. It was not used for this purpose and field edit of the survey was never accomplished. This survey is to be superseded by survey T-12290(2) of project PH-7019 to be compiled from photography of 1970.

Compilation was at 1:20,000 scale by Kelsh Plotter methods using the photography of 29 August 1962. Final review was in the Atlantic Marine Center in June 1971. One cronaflex positive and a negative of the final reviewed survey are forwarded for record and registry.

FIELD INSPECTION REPORT
Project 21059 (PH-6217)
Maps T-12288 thru T-12291
and T-12293 thru T-12295

This report is submitted for seven maps since there is no great difference in terrain, natural or cultural features which would require special treatment.

### 2. AREAL FIELD INSPECTION

The area lies between the North portion of Myrtle Beach, South Carolina to the Cape Fear River in North Carolina. It includes the Intracoastal Waterway and is bordered on the Southeast by the Atlantic Ocean. The photograph coverage is not complete for each map, therefore in accordance with Instructions from Washington, field inspection has been completed to the limits of the photographs with the exception of a few places where photograph coverage extends beyond the map limits.

The area along the Atlantic Ocean is a summer resort. The portion from Myrtle Beach to the North Carolina line is built up almost solid while the area from the North Carolina line to the Cape Fear River is more sparsely settled.

There are several small villages along and near U. S. Highway 17. Some of the larger are: Crescent Beach, Little River, Shallotte and Southport.

The photographic quality was good for the entire area. Photographic tones were found to be similar to other areas along the South Atlantic Coast. The photographs used were flown in both 1962 and 1963, therefore, causing some areas to photograph slightly different. The field inspector has used the more recent photography where possible.

Photographs used for field inspection are listed below for individual maps:

		••	•	•		
T-12293	T-12294	T-12295	T-12288	T-12289	T-12290	T-12291
62 S 851A	62 S 849A	62 S 847A	62 S 832A	62 S 831A	62 S 908A	63 W 3027
62 S 1061A	62 S 850A	62 S 846A	62 S 843A	62 S 827A	62 S 909A	63 W 3025
<b>6</b> 2 S 1062A	63 W 3036	63 W 3034	62 S 845A	62 S 829A	62 S 910A	63 W 3024
<b>62</b> S 1063A	63 W 3037	63 ¥ 3035	63 W 3029	62 S 841A	62 S 911A	62 S 903A
62 S 1064A	63 W 3038		63 W 3030	63 W 3029	62 S 912A	62 S 904A
62 S 851A			63 W 3031		.62 S 913A	62 S 905A
62 S 852A			63 W 3032		62 S 914A	62 S 906A
62 S 853A			63 W 3033		62 S 827A	62 S 907A
62·S 854A						
62 S 855A		•				

### 3. HORIZONTAL CONTROL

Horizontal control recovery and identification has been completed in accordance with project instructions.

The identification of horizontal control was accomplished on 15 February 1964 and forms 152 and 526 (in duplicate) were forwarded to Washington at that time.

PRICE AZIMUTH MARK, 1962 was moved to a new location by this party. See 1964 description and new G.P.

Horizontal control stations reported "lost", "destroyed", or "not recovered" are listed below by maps:

### <u>T-12293</u>

SANDY, 1934 INTRACOASTAL WATERWAY STA. 730/84.60, 1934 NIXON, 1923

### T-12294

INTRACOASTAL WATERWAY BEACON NO. 46, 1934 LITTLE RIVER BEACON NO. 8, 1934

### T-12295

INTRACOASTAL WATERWAY BEACON NO. 77, 1934 BIRD, 1962

### T-12288

SAUCE, 1934
TUBBS, 1934
SYLVIA, 1934
BALD BEACH, 1962
INTRACOASTAL WATERWAY BEACON NO. 38, 1934
INTRACOASTAL WATERWAY BEACON NO. 36, 1934
INTRACOASTAL WATERWAY BEACON NO. 42, 1934
INTRACOASTAL WATERWAY BEACON NO. 55, 1934
INTRACOASTAL WATERWAY BEACON NO. 57, 1934
INTRACOASTAL WATERWAY BEACON NO. 59, 1934
INTRACOASTAL WATERWAY BEACON NO. 61, 1934
INTRACOASTAL WATERWAY BEACON NO. 71, 1934
INTRACOASTAL WATERWAY BEACON NO. 73, 1934
INTRACOASTAL WATERWAY BEACON NO. 75, 1934

### T-12289

HEWETT, 1934
LOCKWOOD, 1934
FISH, 1923
CHADWICK, 1934
TAR, 1934
INTRACOASTAL WATERWAY BEACON NO. 29, 1934
INTRACOASTAL WATERWAY BEACON NO. 30, 1934

INTRACOASTAL WATERWAY BEACON NO. 32, 1934 INTRACOASTAL WATERWAY BEACON NO. 34, 1934 INTRACOASTAL WATERWAY BEACON NO. 35, 1934 INTRACOASTAL WATERWAY BEACON NO. 45, 1934 INTRACOASTAL WATERWAY BEACON NO. 51, 1934

### T-12290

WATERWAY, 1934 BIG HILL, 1905 INTRACOASTAL WATERWAY BEACON NO. 23, 1934

### T-12291

A. L. (U.S.E.), 1923 CORMCAKE, 1962 FUZZY, 1933 3 (U.S.E.), 1933 BRIDGE, 1933 ROAD, 1933 OAK, 1933 R. B., 1923

### 4. VERTICAL CONTROL

A search was made for all tidal bench marks within the limits of these maps. Form 685A is submitted for each mark.

### 5. CONTOURS AND DRAINAGE

Contours are inapplicable.

Drainage is almost entirely composed of tidal streams. Normal drainage is generally by direct run-off into marsh or swamp.

### 6. WOODLAND COVER

Woodland Cover was classified in accordance with the Topographic Manual.

### 7. SHORELINE AND ALONGSHORE FEATURES

The high-water line has been indicated on the photographs by symbol in accordance with current instructions. No attempt was made to delineate the low-water line. The delineation of the high-water line was accomplished by several methods: Measurements from identifiable points of detail; by visual inspection from skiff; and by walking the shoreline.

All other shoreline features are adequately covered by field inspection notes on the photographs. There have been few developments since photography. Included with the map data for T-12289 is a tracing of a surveyors map of a new development along the Intracoastal Waterway. The field inspector has located several common points of detail photogrammetrically.

The field inspector has delineated the shoreline on the 1963 photographs where possible. The compiler will note, along the Intracoastal Waterway, a mud bank where the 1963 photographs were flown at a lower tide than the 1962 ones.

### 8. OFFSHORE FEATURES

A letter-size section of the chart is submitted with Map T-12291. Several piling, wrecks, etc: were located by sextant or theodolite cuts.

### 9. LANDMARKS AND AIDS

A thorough inspection of Nautical Landmarks was made. Form 567 is submitted for each. A few have been shown for delegation and a few new ones are recommended.

All fixed aids to navigation are reported on form 567 for charting. There was only a few changes. A few new daybeacons and one rear range light have been added at the Oak Island Entrance in Map T-12291. The aids were located by several photogrammetric methods, namely: direct method, theodolite cuts from triangulation stations and photo points, and by sextant.

### 10. BOUNDARIES, MONUMENTS AND LINES

There have been no boundary lines shown.

### 11. OTHER CONTROL

There were no marked topographic stations established.

### 12. OTHER INTERIOR FEATURES

All roads were classified in accordance with Photogrammetric Instructions No. 56.

Field Inspection of buildings was done in accordance with Photogrammetric Instructions No. 54, revised September 22, 1961.

There were no bridge or cable clearances measured during this survey.

Marsh and swamp limits have been shown on the photographs where coverage was available.

### 13. GEOGRAPHIC NAMES

See Special Report of Geographic Names, Project 21059, which was submitted to Washington on 5 February 1964.

### 14. SPECIAL REPORTS AND SUPPLEMENTAL DATA

Control Identification to Washington 10-16-63.
Control Identification to Washington 10-24-63.
Map Data T-12300 thru T-12302 to Tampa 1-17-64.
Geographic Names Report to Washington 2-10-64.
Control Identification to Washington 2-13-64.
Map Data T-12298 to Tampa 2-25-64.
Map Data T-12292, T-12296, T-12297 and T-12299 to Tampa 3-4-64.

23 April 1964 Submitted by:

Joseph K. Wilson

Chief, Photo Party 6420

### AEROTRIANGULATION REPORT

Project No. 21059

Cape Fear to North Carolina

Winyah Bay to South Carolina

### 21. Area Covered

This report covers aerotriangulation bridging of the Atlantic Coast from Myrtle Beach, South Carolina to Cape Fear, North Carolina (T-Sheets T-12288 thru T-12295 and T-12297).

### 22. Method

Three strips were bridged on the stereoplanigraph and adjusted by TBM 1620 methods. All stations held within National Map Accuracy Standards, with the exceptions of Corneake RM #1, 1962 (Strip #3) and Goat, 1934, SSTAT. All tie points were averaged. Plotting coordinates are furnished at 1:10,000 scale.

### 23. Adequacy of Control

Horizontal control provided was adequate in quality and coverage, with the exception of Corncake RM # 1, 1962, which could not be held in strip #3. It is believed that the RM #1 has been disturbed (see Form 526 Recovery Note). Another station should be identified in the area to complete T-Sheet No. T-12291, Goat 1934, SSA could not be clearly identified in strip #1 and was eliminated from the bridge.

## 24. Supplemental Data

None

## 25. Photography

Photography was adequate as to coverage, overlap, and definition.

Submitted by:

Approved by:

4



DESCRIPTIVE REPORT CONTROL RECORD

MAP T-	PROJECT NO. FR-DCL/	SC/	SCALE OF MAP_I:20,000 SCA	SCALE FACTOR
STATION	SOURCE OF INFORMATION (INDEX)	DATUM	LATITUDE OR Y COORDINATE LONGITUDE OR X COORDINATE	N.A. 1927 - DATUM DISTANCE FROM GRID OR PROJECTION LINE IN METERS (1 Ft. = 3048006 meter) FORWARD (BACK)
BIG HILL, 1905	pg. 187	NA 1927	60,883,37	
BONHAM, 1934	pg. 226	=		
FOLLY, 1934	pg. 226	=	1 ~1	
HOWELL, 1932	pg. 37	=	1 1	
LOCK, 1962	Vol. 3 pg. 2824	<b>=</b>	61,161.81	
WAITERWAY, 1934	pg. 226	<u>=</u>	1 1 1 1	
WOINZ, 1962	Vol. 3 pg. 2825	=	61,313.13 2, 248,726.34	
The state of the s				
computed BY B. L. Barge	DATE 2/9/65	 	снескер ву В. Н. Barnes	<u>рате</u> 2/9/65

### COMPILATION REPORT T-12290

### 31. DELINEATION

Compilation was by Kelsh Plotter methods using the photography of August 29, 1962. The field inspection was adequate and no difficulties were encountered in the delineation of the survey.

### 32. CONTROL

See Photogrammetric Plot Report.

### 33. SUPPLEMENTAL DATA

None

### 34. CONTOURS AND DRAINAGE

Contours are inapplicable. Drainage was delineated by office interpretation of the photography.

### 35. SHORELINE AND ALONGSHORE DETAILS

The shoreling inspection of the mean high water line was adequate for delineation. The mean low water line was delineated from office interpretation.

### 36. OFFSHORE DETAIL

Only one of the two wrecks located near the entrance to Lockwoods Folly Inlet was found by the field inspector. This was the northwesterly of the two wrecks and was located by a sextant fix. Neither of the wrecks are visible on the photographs of the area.

### 37. LANDMARKS AND AIDS

Form 567 for the fixed aids to navigation will be submitted at a later date.

### 15

### 38. CONTROL FOR FUTURE SURVEYS

None

### 39. JUNCTIONS

Satisfactory junctions were made with T-12289 to the west and with T-12291 to the east. There are no contemporary surveys to the north or south.

### 40. HORIZONTAL AND VERTICAL ACCURACY

No statement.

### 46. COMPARISON WITH EXISTING MAPS

Comparison has been made with USGS Lockwoods Folly, N.C. 1:24,000 scale quadrangle, dated 1943.

### 47. COMPARISON WITH NAUTICAL CHARTS

Comparison was made with chart 835-SC, 1:40,000 scale, revised November 30, 1959.

### ITEMS TO BE APPLIED TO NAUTICAL CHARTS IMMEDIATELY

None

### ITEMS TO BE CARRIED FORWARD .

None

A. Santillan Cartographer a. Santillan

Approved for forwarding:

Melvin J. Umbern, COR, NOAA Chief, Photogrammetry Division, AMC

Approved:

Allen L. Powell, RADM, NOAA Director, Atlantic Marine Center

### May 28, 1971

### GEOGRAPHIC NAMES

### FINAL NAME SHEET

### PH-6217 (North Carolina)

### T-12290

Ash Swamp Lockwoods Folly River

Atlantic Ocean Long Bay

Davis Canal Long Beach (beach)

Davis Creek Long Beach (town)

Eastern Bend Mullet Creek

Eastern Channel Myrtle Point

Gences Point Oak Island

Holden Beach (beach) Pinner Point

Horse Island Sheep Island

Howell Point Spring Creek

Intracoastal Waterway Tranquil Harbor (resort)

Lockwoods Creek Varnum Town

Lockwoods Folly Inlet

Approved by:

A. Voseph Wraight Chief Geographer Prepared by:

Frank W. Pickett

Cartographic Technician

### 49. NOTES FOR THE HYDROGRAPHER

A wreck near latitude 33° 54.6' longitude 78° 14.2' was not found by the field inspector and is not visible on photographs of the area. This is the southeasterly of two wrecks shown on chart 835-SC at the entrance to Lockwoods Folly Inlet.

FORM C&GS-1002 U.S. DEPARTMENT OF COMMERCE ESSA COAST AND GEODETIC SURVEY PHOTOGRAMMETRIC OFFICE REVIEW T- 12290 3. MANUSCRIPT NUMBERS 4. MANUSCRIPT SIZE 1. PROJECTION AND GRIDS 2 TITLE RES RES RES RES CONTROL STATIONS 5. HORIZONTAL CONTROL STATIONS OF THIRD-ORDER OR HIGHER ACCURACY 6. RECOVERABLE HORIZONTAL STATIONS
OF LESS THAN THIRD-ORDER ACCURACY
(Topographic stations) 7. PHOTO HYDRO STATIONS  $\mathbf{X}\mathbf{X}$ XX XX 8. BENCH MARKS 9. PLOTTING OF SEXTANT 10. PHOTOGRAMMETRIC 11. DETAIL POINTS XX RRW RES Kelsh ALONGSHORE AREAS (Nautical Chart Data) 12. SHORELINE 13. LOW-WATER LINE 14. ROCKS, SHOALS, ETC. 15. BRIDGES RES RES RES XX 16. AIDS TO NAVIGATION 17. LANDMARKS 18. OTHER ALONGSHORE PHYSICAL FEATURES 19. OTHER ALONGSHORE CULTURAL FEATURES RRW RRW RES RES PHYSICAL FEATURES 20. WATER FEATURES 21, NATURAL GROUND COVER 22. PLANETABLE CONTOURS RES XX23. STEREOSCOPIC INSTRUMENT CONTOURS 24. CONTOURS IN GENERAL 25. SPOT ELEVATIONS 26. OTHER PHYSICAL FEATURES RES CULTURAL FEATURES 27. ROADS 28. BUILDINGS 29. RAILROADS 30. OTHER CULTURAL FEATURES RES RES XXXXBOUNDARIES 31. BOUNDARY LINES 32. PUBLIC LAND LINES MISCELLANEOUS 33. GEOGRAPHIC NAMES 34. JUNCTIONS 35. LEGIBILITY OF THE RES RES RES 38. FIELD INSPECTION PHOTOGRAPHS 36. DISCREPANCY OVERLAY 37. DESCRIPTIVE REPORT 39. FORMS RRW & RES RES RES RES 40. REVIEWER SUPERVISOR, REVIEW SECTION OR UNIT R. E. Smith Alburt K. Ruack 41. REMARKS (See attached sheet) FIELD COMPLETION ADDITIONS AND CORRECTIONS TO THE MANUSCRIPT 42. Additions and corrections furnished by the field completion survey have been applied to the manuscript. The manuscript is now complete except as noted under item 43. COMPILER SUPERVISOR 43. REMARKS

### REVIEW REPORT T-12290

### SHORELINE

June 3, 1971

### 61. GENERAL STATEMENT

See Summary, which is page 6 of the Descriptive Report.

### 62. COMPARISON WITH REGISTERED TOPOGRAPHIC SURVEYS

Comparison was made with a copy of T-8198. This 1:20,000 scale survey made in 1944 is a part of the 7 1/2 minute series of standard topographic quadrangle maps, printed and distributed by the U. S. Geological Survey. All differences noted that exist between surveys T-8198 and T-12290 will therefore also exist between the Lockwoods Folly, N.C. 1:24,000 scale quadrangle and T-12290.

Some erosion of the shoreline has occurred since the time of the older survey particularly in and around Lockwoods Folly Inlet. The Intracoastal Waterway has been widened and the fixed aids to navigation relocated. Survey T-8189 is now obsolete. It is superseded by T-12290 for nautical chart construction purposes.

### 63. COMPARISON WITH MAPS OF OTHER AGENCIES

Comparison was made with USGS Lockwoods Folly Inlet, N.C. quadrangle, 1:24,000 scale, edition of 1943. See Item 62 above.

### 54. COMPARISON WITH CONTEMPORARY HYDROGRAPHIC SURVEYS

There were no contemporary hydrographic surveys available for comparison purposes at the time of final review.

### 65. COMPARISON WITH NAUTICAL CHARTS

Comparison was made with chart 835-SC, 8th edition, January 23, 1971. The difference in the shoreline of the two surveys has been indicated on the comparison print in red.

The positions of the following fixed aids to navigation are not in agreement. Some new aids have been built and others moved since the time of field inspection for this survey.

Cape Fear - Little River Daybeacon 28
Cape Fear - Little River Daybeacon 32
Cape Fear - Little River Daybeacon 32
Cape Fear - Little River Light 34
Cape Fear - Little River Daybeacon 39
Cape Fear - Little River Light 40
Cape Fear - Little River Daybeacon 41
Cape Fear - Little River Light 44
Cape Fear - Little River Light 46
Cape Fear - Little River Light 47
Cape Fear - Little River Light 47
Cape Fear - Little River Light 48

The southeasterly of the two wrecks near the entrance to Lockwoods Folly Inlet, latitude 33° 54.6' longitude 78° 14.2', was not located by the field inspector and not visible on the photographs.

A pier near latitude 33° 54.7' longitude 78° 08.8'

is not visible on the photographs.

### 66. ADEQUANCY OF RESULTS AND FUTURE SURVEYS

This survey complies with instructions and meets the National Standards of Map Accuracy.

Reviewed by:

Leo F. Beugnet Cartographer

Approved for forwarding:

Melvin J. Mondach, CDR, NOAA

Chief, Protogrammetry Division, AMC


Approved:


Allen L. Powell, RADM, NOAA

Director, Atlantic Marine Center

Annroved:

Chief, Photogrammetric Branch phothief, Photogrammetry Division

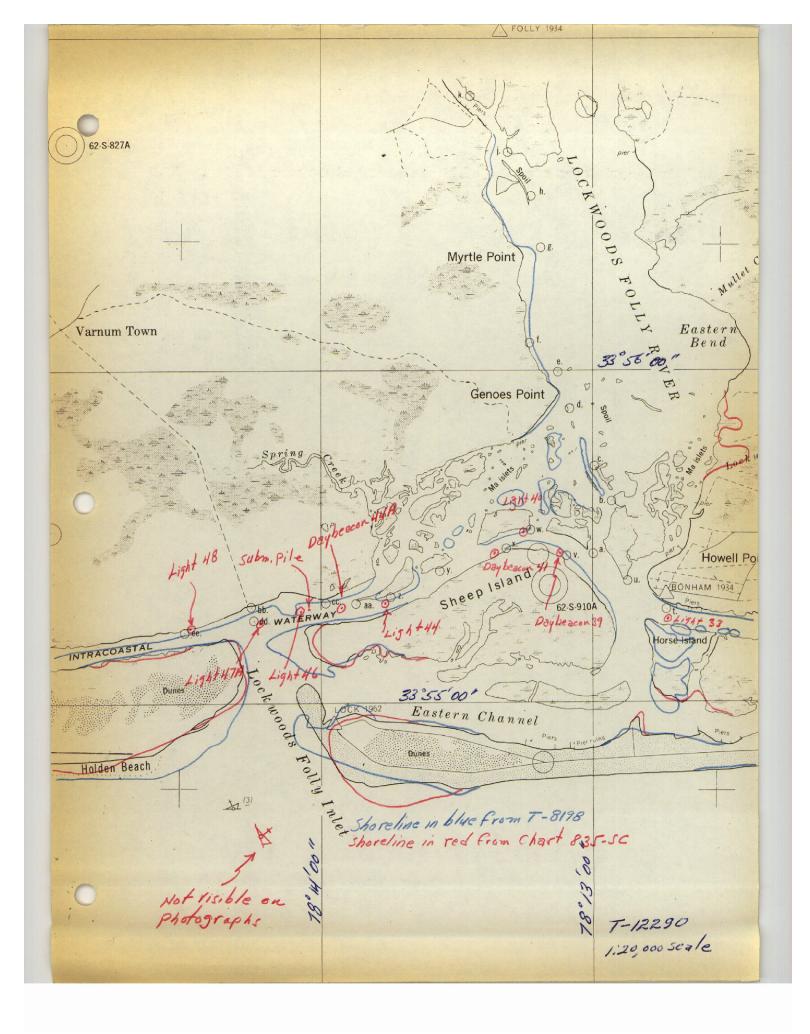

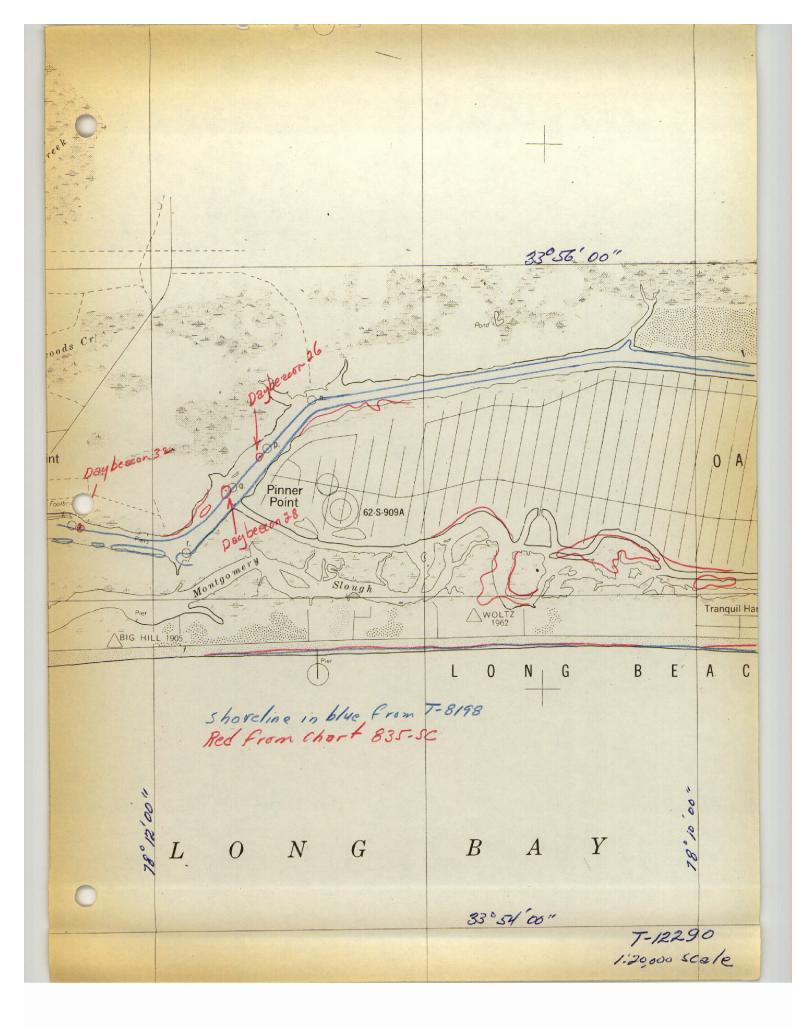

			<i>y</i> =70,000 FT.
Spoil  Ownd cable  WATERWA  Ond Cable  H  I S L A N D  G2-S-908A	Davis Canal  No cridence of Pier on Photographs  Blue From T-8198 Red From Chart 8355C	Swamp 62.S.907A	56' 00"  55'.  y=60,000 FT.
		T-12290 1:20,000 scale	

# U.S. DEPARTMENT OF COMMERCE ENVIRONMENTAL SCIENCE SERVICES ADMINISTRATION COAST AND GEORGIC SURVEY

# NONFLOATING AIDS OR LANDMARKS FOR CHARTS

TO BE CHARTED

NOTICE OUT TWO

TOKKENDENSEMBED

STRIKE OUT TWO

ATTANTIC MARINE CENTER

April 1, 19 65

I recommend that the following objects which have (have not) been inspected from seaward to determine their value as landmarks be charted on (Additional) the charts indicated.

The positions given have been checked after listing by B. Willson

STATE CHARTING NAME													-			-	<u> </u>	
<del>                                     </del>			,						:	POSITION	z			METHOD				
<del>-      </del>	Sorth 	North Carolina	lina					Ţ	LATITUDE*	3	LONGITUDE	*		LOCATION	DATE			CHARTS
			DESCRIPTION	NOLE		S	BIGNAL		D.M. METERS	•	9	D. P. METERS	DATUM	SURVEY No.	LOCATION	OBBAN	OKSHI OFFEN	AFFECTED
	Intra	Intracoastal	al Wat	Waterway												_		
	Cape	Fear.	Fear-Little		River Light 2	54		33 55	35,90 1106	78 11	2	92	N.A.	Photo. T-12290	49/21/2			835-SC
	£	=	11	11 I	Daybeacon26	26		33 55	27.00 832	78 1	1 34	34.57 888		=	£	<u>.</u>		=
	Ħ	n	H	<b>=</b>	£	28		33 55	20 <u>.12</u> 620	78 11		42,20 1084	11	и	ŧ			=
	=	=	E	E	Light	29		33 55	108°77	78 11		52.56 1350	11	11	=			=
	ŧ	H	11	11 II	Daybeacon32	32		33 55	13,70	78 12		, ,-, ,	E	ı.	=			=
	ŧ	11	11	11	Light	34		33 55	16.75 516	78 1	- Z	43.76	E	ŧ	=			=
	=	=	±	ı.	Daybeacon36	36		33 55	21.88	78 1	- 2	52.40 1346	Ŀ	#	1			#
	ı.		±	#	£	39		33 55	2 <b>6.</b> 42 814	78 13	9	148 148	E	ı.	ı	_	-	<b>=</b>
-	11	±	11	#	Light	40		33 55	31.13	78 1		<u>13.70</u> 352	<b>=</b>	=	=			=
	=	Ħ	11	Ι ,,	Daybeacon41	41		33 55	27.72 854	78 13		19.00 488	ı.	#	Ξ			=
	=	=	ı.	¥.	n	42		33 55	23.66 729	78 1.	. T	3.79 868	11	11	=			=
	=	Ξ	=	#	Light	44		33 55	18.95 584	78 1.	3	44,46 1142	H	11	ш			1
	=	Ξ	=	=	Daybeacon44_A	44+A		33 55	17.95	78 1		52.17 1340	11	ı.	H.			ı.

USCOMM-DC 36485-P66 This form shall be prepared in accordance with Hydrographic Manual, Publication 20.2, Sec. 1-55, 2-39, 6-36, 7-18 to 22 inclusive, and Fig. 79. Positions of charted The data should be landmarks and nonitosting side to navigation, if redetermined, shall be reported on this form. Revisions shall show both the old and new positions. considered for the charts of the area and not by individual field survey sheets. Information under each column heading should be given. \* TABULATE SECONDS AND METERS

C&GS FORM 567

U.S. DEPARTMENT OF COMMERCE COAST AND GEODETIC SURVEY

NONFLOATING AIDS OR LANDMARKS FOR CHARTS

TO BE CHARTED TO BE CHARTED TO BE WELKETED TO BE TO BE

STRIKE OUT TWO

AILANTIC MARINE CENTER

6 April 1,

65

I recommend that the following objects which have (have not) been inspected from seaward to determine their value as landmarks be charted on (ANIENSIX) Troops) the charts indicated.

B. Wilson

The positions given have been checked after listing by

CHARTS NOME of Party. 835-SC = = = = = = = = = = = ¥ THAND BEOMENIC TRAND SHORE HARBOR CHART Powell, RADM 3/13/64 LOCATION DATE = = Ξ = = = = = = = E = Photo. T-12290 METHOD OF LOCATION AND BURVEY No. Allen L. = = = = = = = = = = = = DATUM 1927 M = = = = E = = = = = = = 00.00 59-65 1532 14.83 381 05.06 30.08 D. P. METERS 1512 1534 394 58.87 757 86 291 LONGITUDE \* 13 13 7 14 74 72 72 13 33 13 13 73 POSITION 78 0 28 28 38 28 8 23 78 28 28 29 28 82 D.M.METERS 31.84 53.634 59,66 1838 1315 18.05 36.32  $\frac{39.73}{1224}$ 1 1 1 1 1 1 1 1 1 1 556 532 LATITUDE 20 20 26 28 55 5 23 55 55 25 55 23 5 33 9 33 33 33 33 33 33 33 33 33 33 33 BIGNAL Daybeacon46-10 46 48 4  $\Box$ 9  $\infty$ €, **~** σ 42 River Daybeacord Fear-Little River Light Light = Ξ = = = = = = = DESCRIPTION = = = = = = = = = F011y = = Ξ = = = = Ξ Ξ = = STATE North Carolina ockwoods = = = = Ξ = = = = = Ξ Cape = = = CHARTING

Positions of charted The data should be This form shall be prepared in accordance with Hydrographic Manual, Publication 20.2, Sec. 1-55, 2-39, 6-36, 7-18 to 22 inclusive, and Fig. 79. landmarks and nonfloating aids to navigation, if redetermined, shall be reported on this form. Revisions shall show both the old and new positions. considered for the chatts of the area and not by individual field survey sheets. Information under each column heading should be given.

\* TABULATE SECONDS AND METERS

USCOMM-DC 16234-P61

U.S. DEPARTMENT OF COMMERCE
ENVIRONMENTAL SCIENCE SERVICES ADMINISTRATION
COAST AND GP ETIC SURVEY

NONFLOATING AIDS OR LANDMARKS FOR CHARTS TO BE CHARTED TOWNERS TOWNER T

STRIKE OUT TWO

ATLANTIC MARINE CENTER

April 1, 19 65

I recommend that the following objects which have (have not) been inspected from seaward to determine their value as landmarks be charted on (ACLORAL MESSA) the charts indicated.

B. Wilson The positions given have been checked after listing by \_

ОТТОВ С В В В В В В В В В В В В В В В В В В						NO EE					25	
Lockwoods Folly River   14   15   15   15   16   17   18   17   18   19   19   19   19   19   19   19		Jorth Carolina				NO I I I			dorting No.		BAH:	
Description   Description				3	TTUDE#	LON	OITUDE #		LOCATION		384	AFFECTED
Lockwoods Folly River	CHARTING	DESCRI	IPTION	1	D.M. METERS		D. P. METERS	DATUM	CURVEY No.	OCATION	HSNI	
1		Lockwoods Folly	Daybeacon 12 River	33 56			27.02 694	NA 1927	Photo T-12290			825-SC
			11 11	33 57			34,78 893	11	11			11
	£											
												:
		,										
								•				

This form shall be prepared in accordance with Hydrographic Manual, Publication 20.2, Sec. 1-55, 2-39, 6-36, 7-18 to 22 inclusive, and Fig. 79. Positions of chatted The data should be landmarks and nontionting aids to navigation, if redetermined, shall be reported on this form. Revisions shall show both the old and new positions. considered for the charts of the area and not by individual field survey sheets. Information under each column heading should be given. \* TABULATE SECONDS AND METERS

£

USCOMM-DC 36485-P66

### **RECORD OF APPLICATION TO CHARTS**

FILE WITH DESCRIPTIVE REPORT OF SURVEY NO.

7	_/	2	290	
	•	-		

### INSTRUCTIONS

- A basic hydrographic or topographic survey supersedes all information of like nature on the uncorrected chart.
- 1. Letter all information.

In "Remarks" column cross out words that do not apply.
 Give reasons for deviations, if any, from recommendations made under "Comparison with Charts" in the Review.

- 1	CHART	DATE	CARTOGRAPHER	REMARKS
	8.35SCA	10-21-71	La Mare	Fall Part Baiss After Verification Review Inspection Signed Via
) [				Drawing No.
1	1236	1-11-72	R.a. Lillis	Full Part Defore After Verification Review Inspection Signed Via
Ţ		·		Drawing No. Consider feelly applial
) <b> </b>	1236	11-26-74	& Bodoruna	superseded by 1979 1974 Scafe
1			<u> </u>	Full Part Before After Verification Review Inspection Signed Via
-				Drawing No.
F			·	
ŀ				Full Part Before After Verification Review Inspection Signed Via
)  -				Drawing No.
ŀ				
}				Full Part Before After Verification Review Inspection Signed Via
ŀ				Drawing No.
) <b> </b> -				Tall Dear to Contact and Contact Dear to the Contact Dear
}		j		Full Part Before After Verification Review Inspection Signed Via Drawing No.
┝				Drawing Ivo.
┢		· · · <u></u>	<u> </u>	Full Part Before After Verification Review Inspection Signed Via
$\cdot$				Drawing No.
)  -				Diving Ito.
+				Full Part Before After Verification Review Inspection Signed Via
-				Drawing No.
r				
				Full Part Before After Verification Review Inspection Signed Via
				Drawing No.
Γ				Full Part Before After Venification Review Inspection Signed Via
Γ	,			Drawing No.
Τ			,	
ŀΓ				
Γ		· · · · · · · · · · · · · · · · · · ·		
			<del></del>	